


Amended
Profile

Hapiers n^o 463 -

S.S. ["]Moravian["]

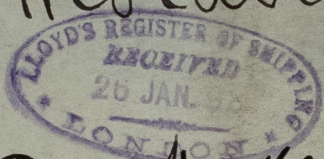

Glb Rpt. No. 16720



© 2021

Lloyd's Register
Foundation

8500-42574