


24/1/98

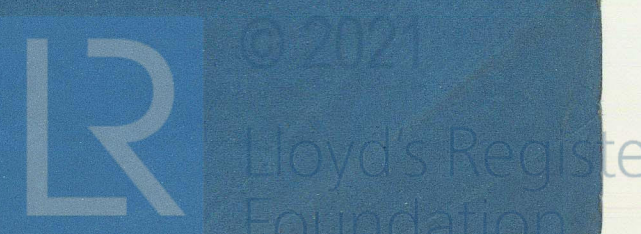




Amended  
Deck plans

Kapers 463

S.S. "Maravian".

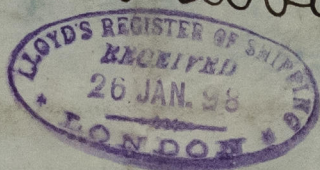

Glasgow Report No. 16720



© 2021

Lloyd's Register  
Foundation





© 2021

Lloyd's Register  
Foundation