


Nº 463

29354

STERNPOST.

SCALE $\frac{1}{2}$ " = 1 FOOT.

Handwritten notes:
 22/12/97
 M. E. C.

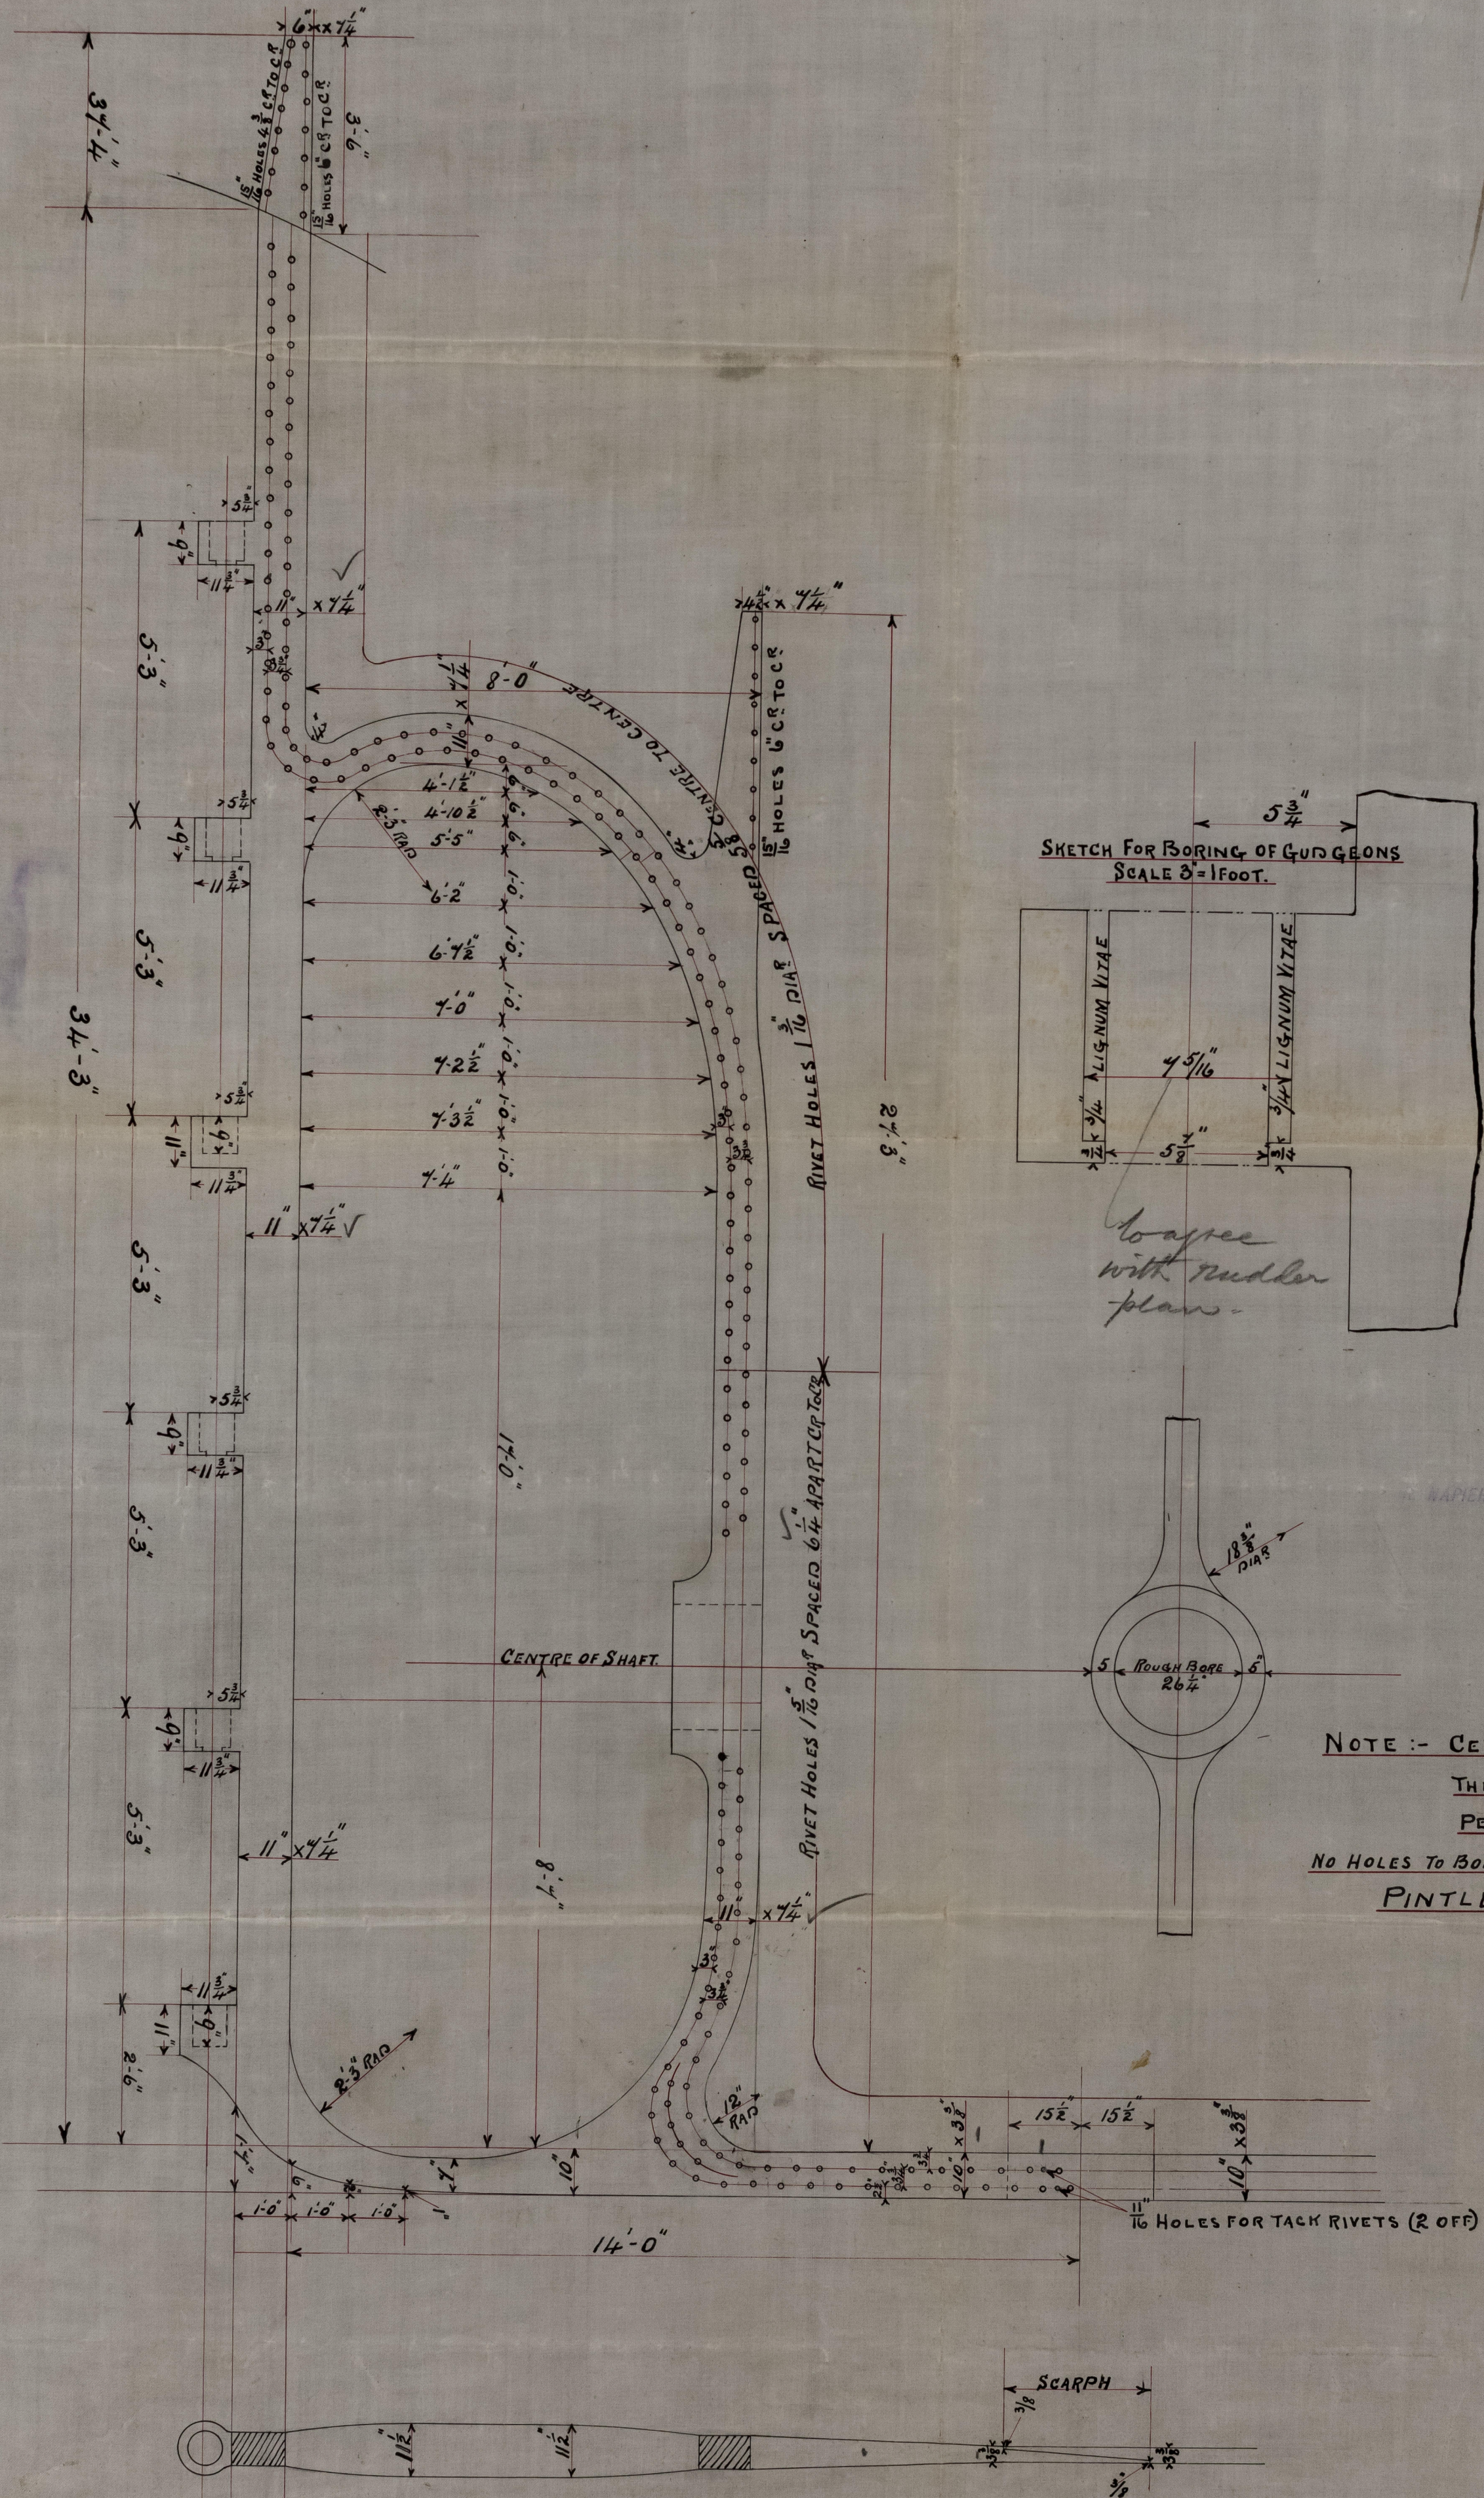

Parting No. 34937

22/12/97



© 2021 Lloyd's Register Foundation

R. Napier & Sons
N^o 463

Stem Frame

S.S. Moravian.

Glasgow Report

No. 16720

NOTE: CENTRE LINE OF PINTLE HOLES

THROUGH GUDDGONS TO BE IN A

PERFECTLY STRAIGHT LINE

NO HOLES TO BE DRILLED IN THE ENDS OF KEEL SCAPES

PINTLES 5/4" DIAMETER

16 HOLES FOR TACK RIVETS (2 OFF)



© 2022

Lloyd's Register
Foundation

65374-0062