

Nº 4-63

29302.

RUDDER.


SCALE $\frac{1}{2}'' = 1$ FOOT.

20.12.97

PLAN OF COUPLING


SCALE 3" = 1 FOOT.

6. $2\frac{3}{4}$ BOLTS THROUGH COUPLING

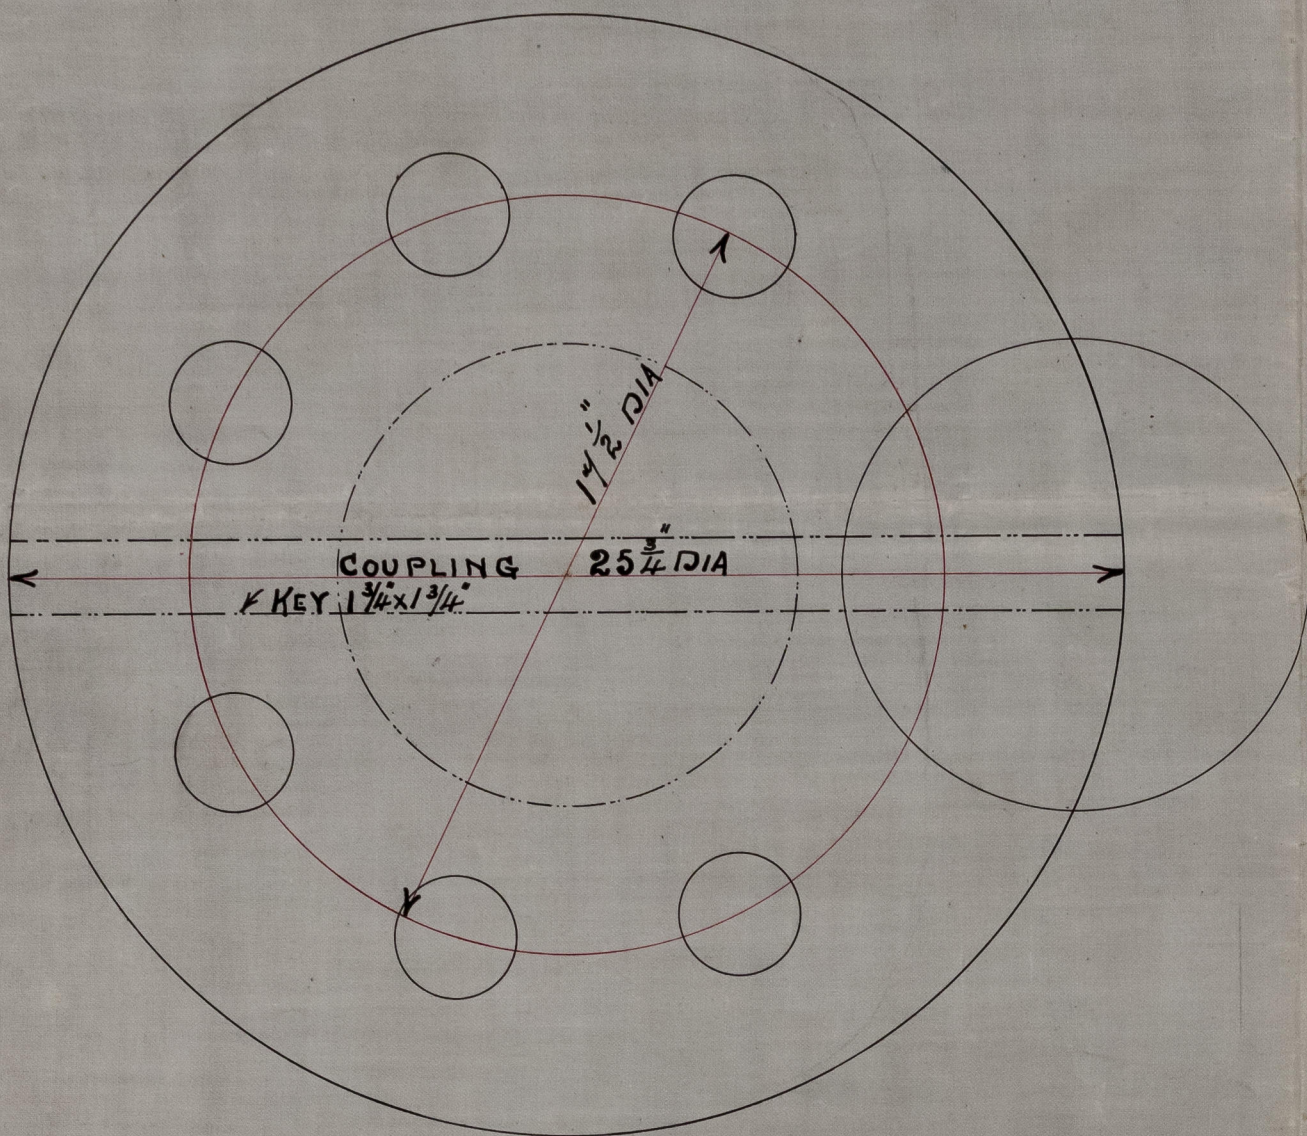

1ST NUMERAL 92.69.
DRAUGHT TO KEEL }
OF RUDDER } 22-1"
SPEED IN KNOTS 13.7

Ch. A. Leggett
10/12/94

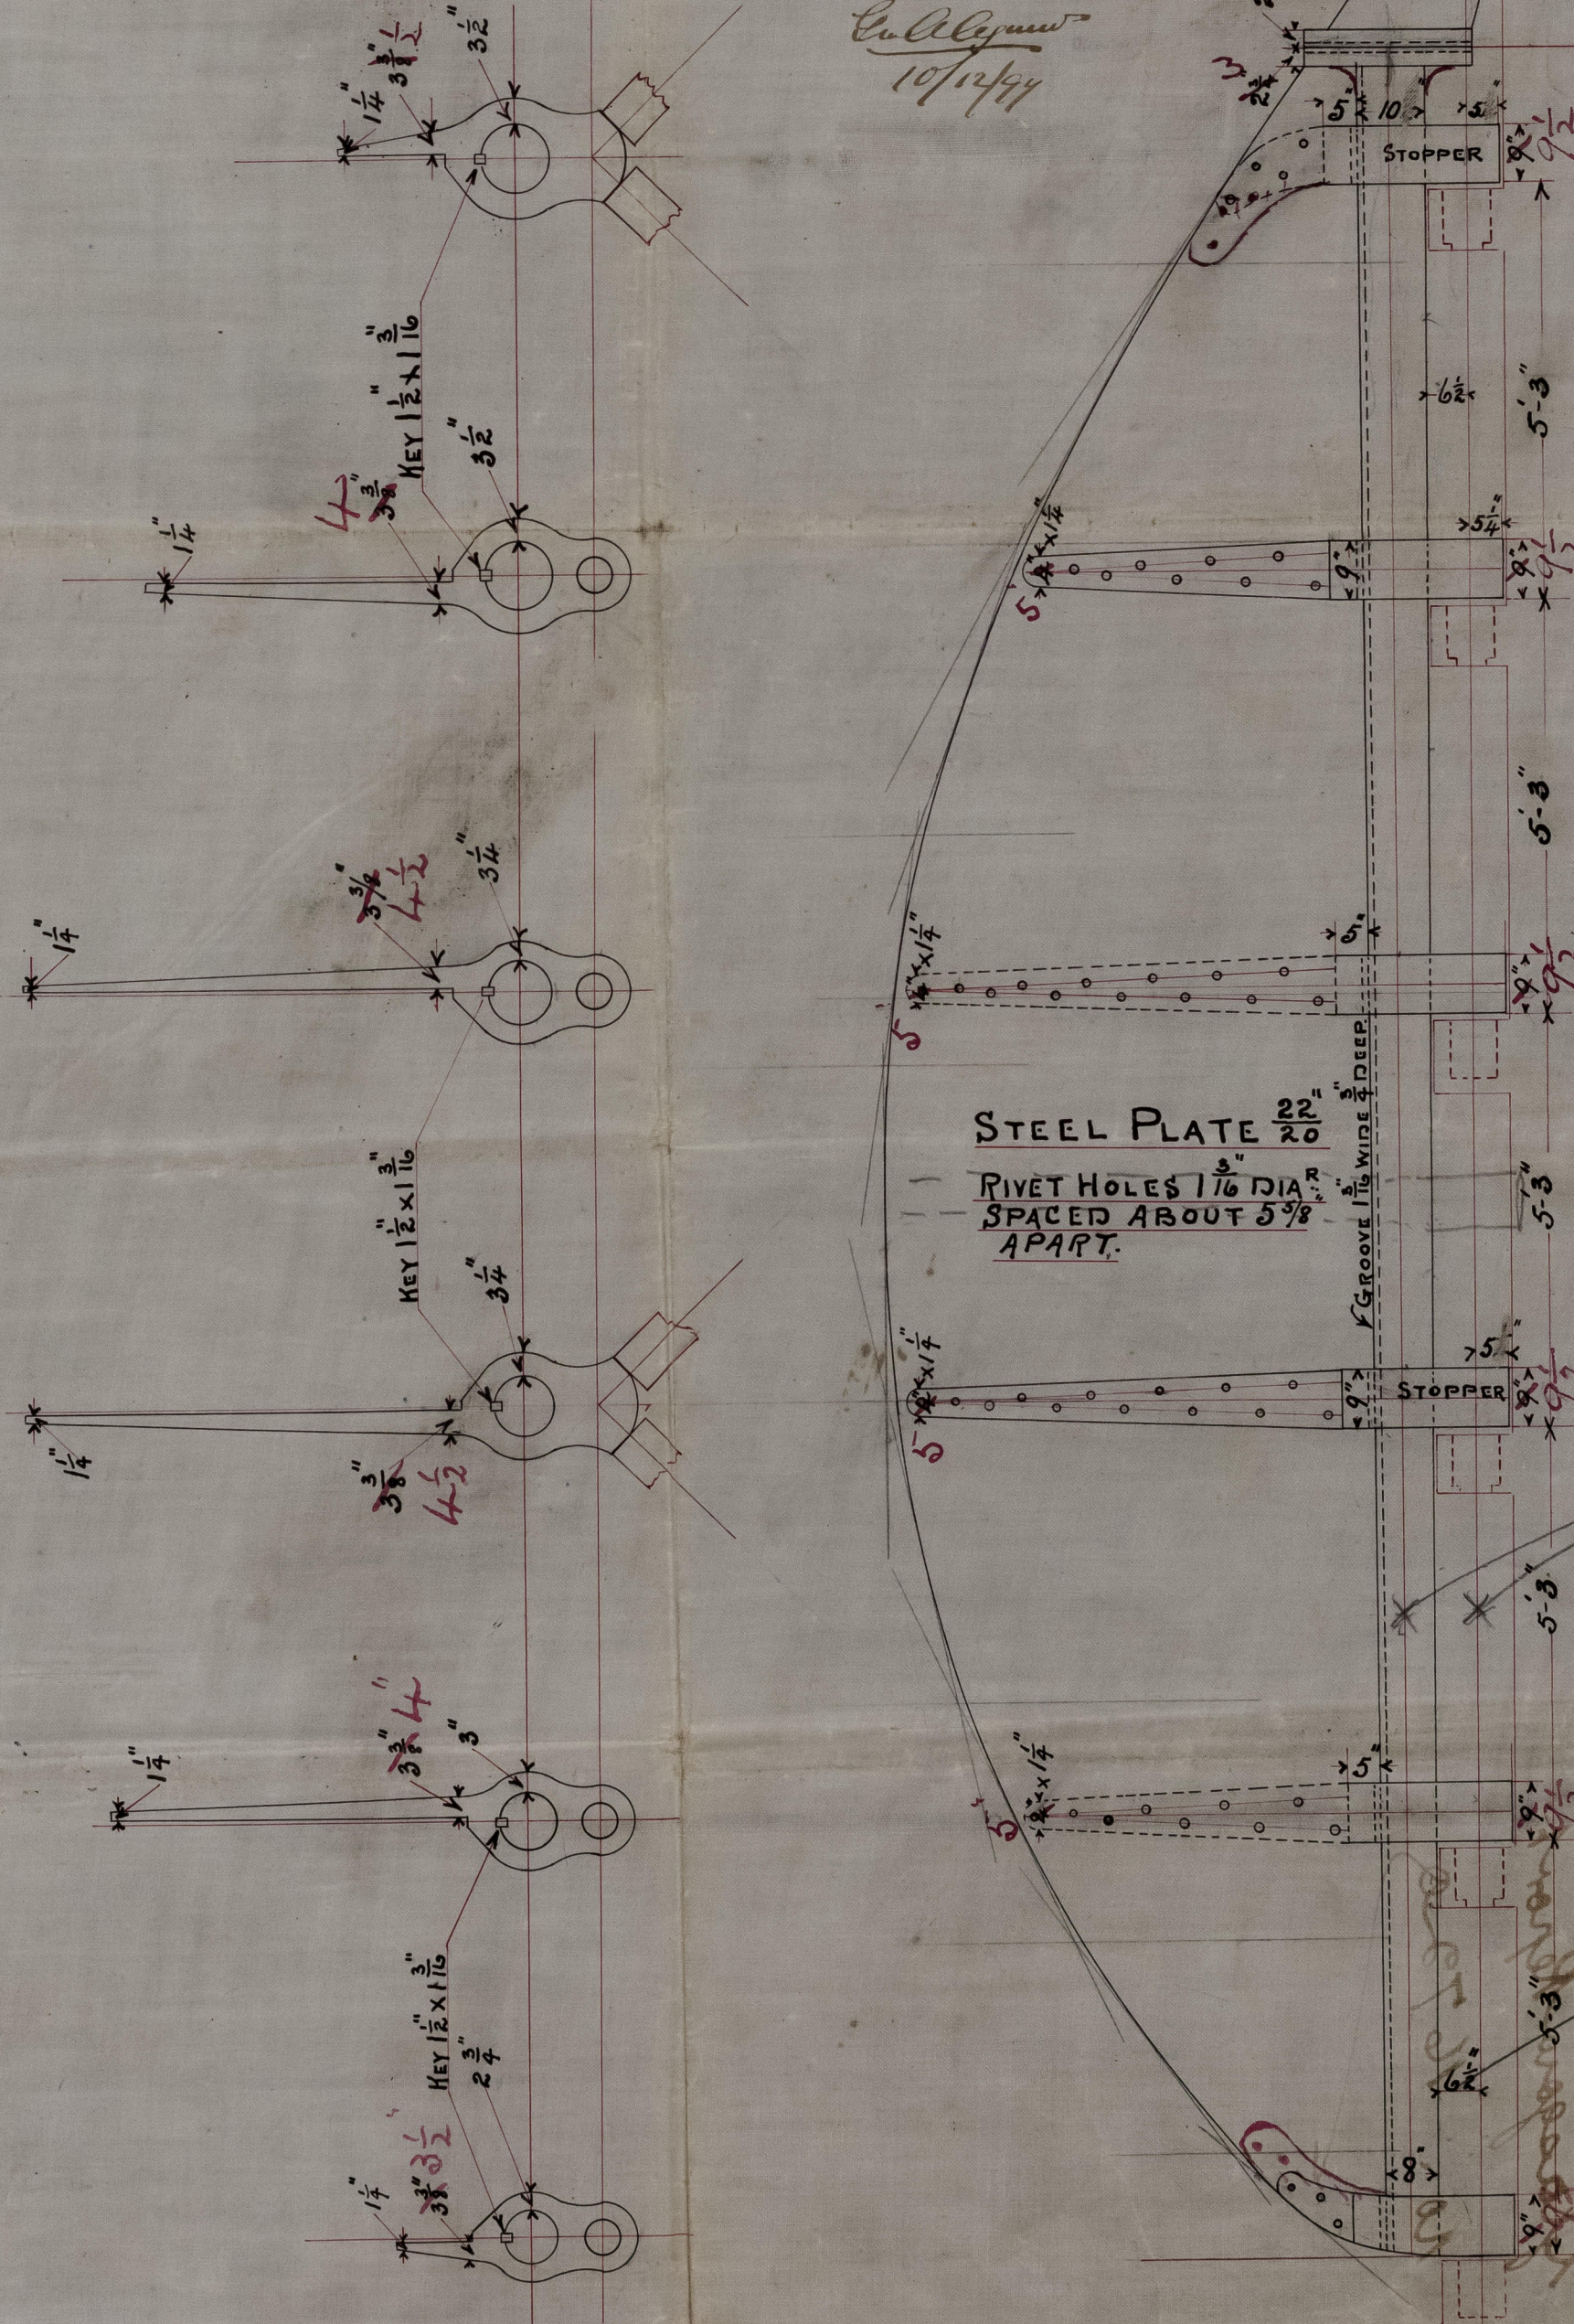

are
these parallel
lines.

227 $\frac{1}{2}$

Plating No 34937 Spm Ok Rule
38379 3 Ok do

Se 18/12/97

625274-0065

R. Napier & Sons

N^o 463


Rudder

S.S. "Moravian"

Glasgow Report

No. 16720

41374-0065

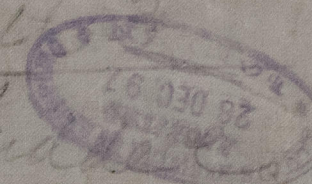

RUDDER
Tool = 3 1/2 x 1 1/2







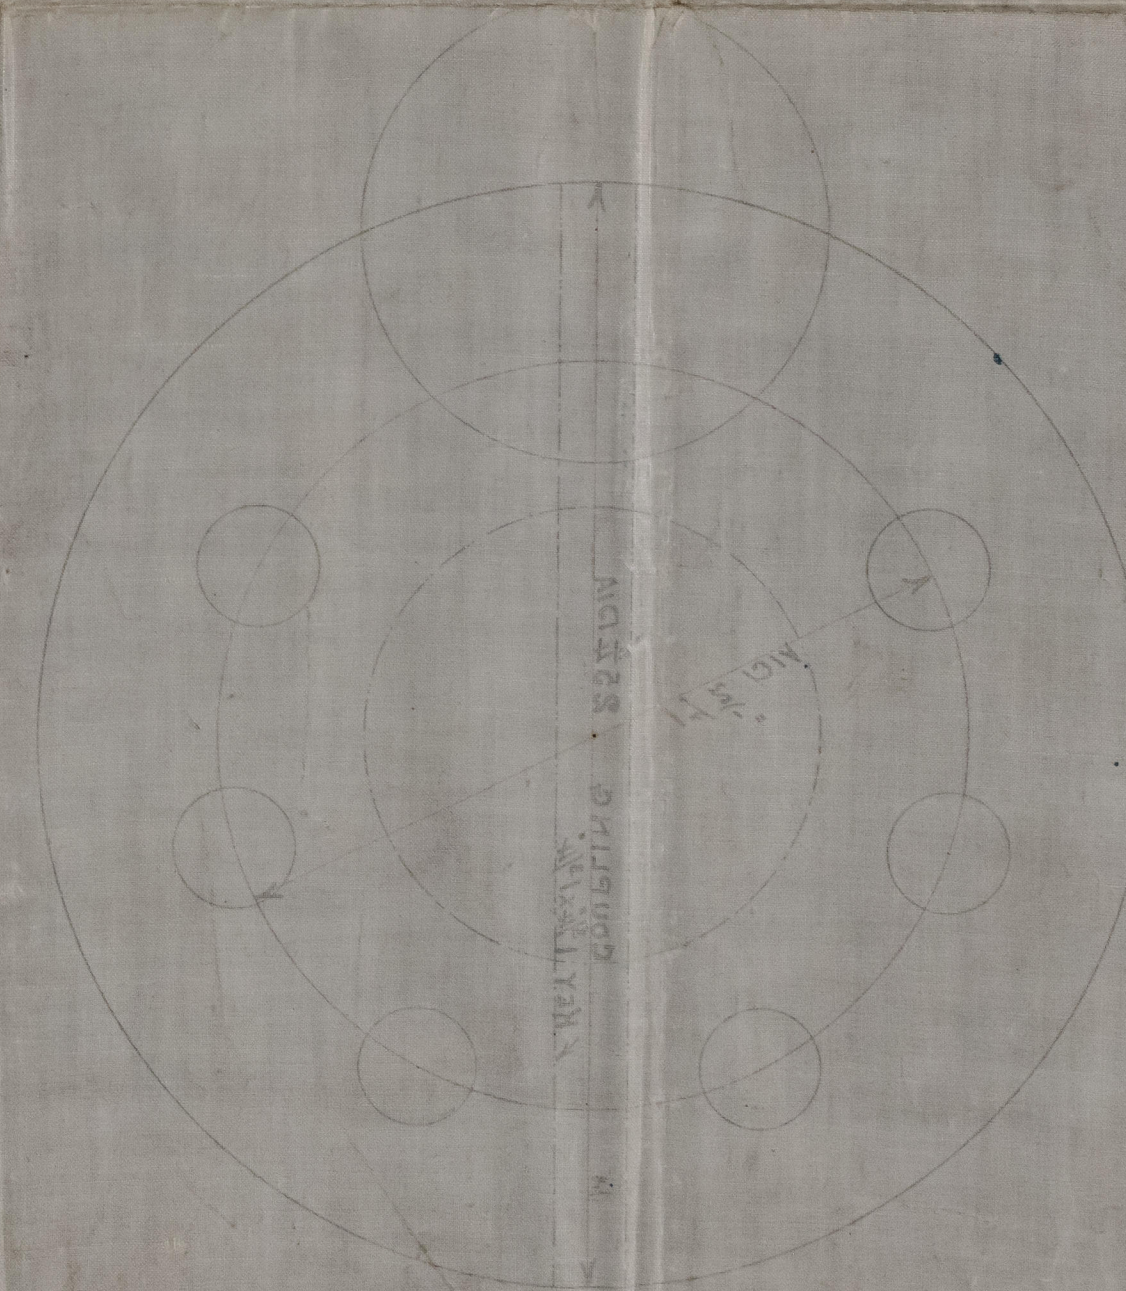


