
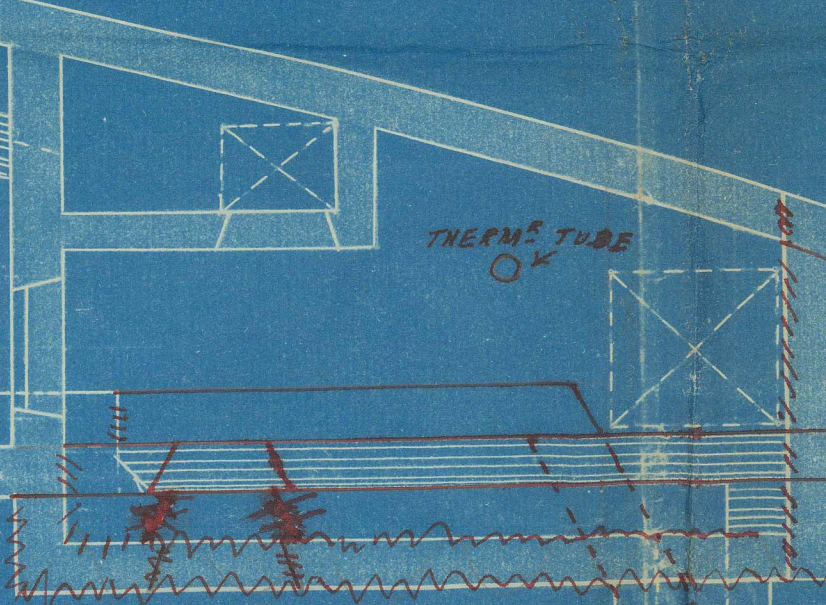
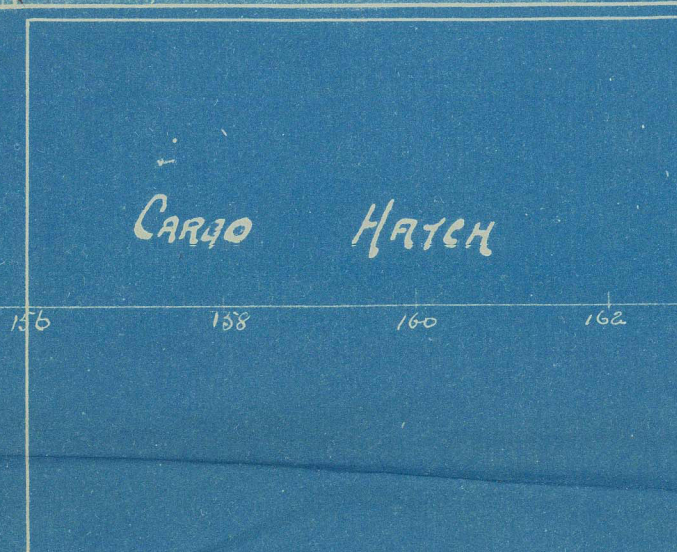


29901  
Nº 4-63

S.S. 'Marian'





MAIN DECK  
Scale 1/4 inch = One foot

upper water tank  
lower water tank  
upper water tank

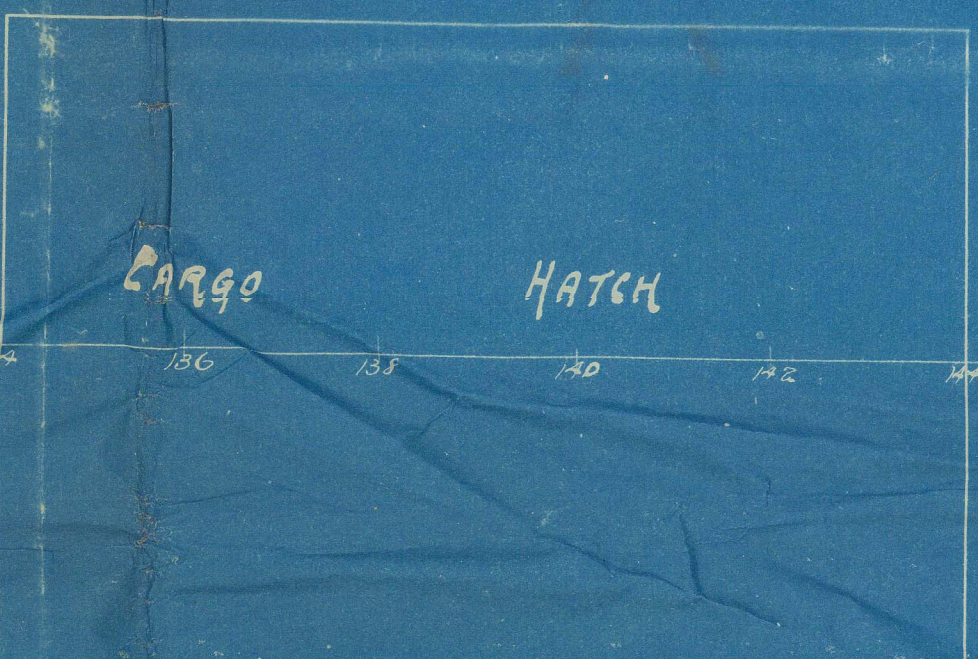

Insulation carried straight along  
as shown in red

LOWER DECK

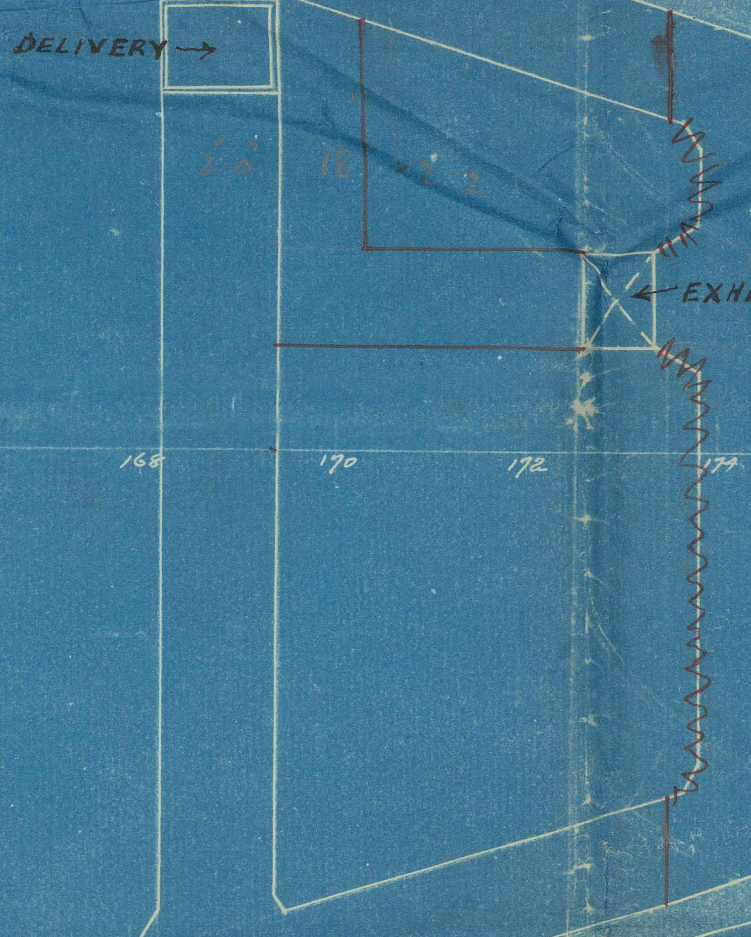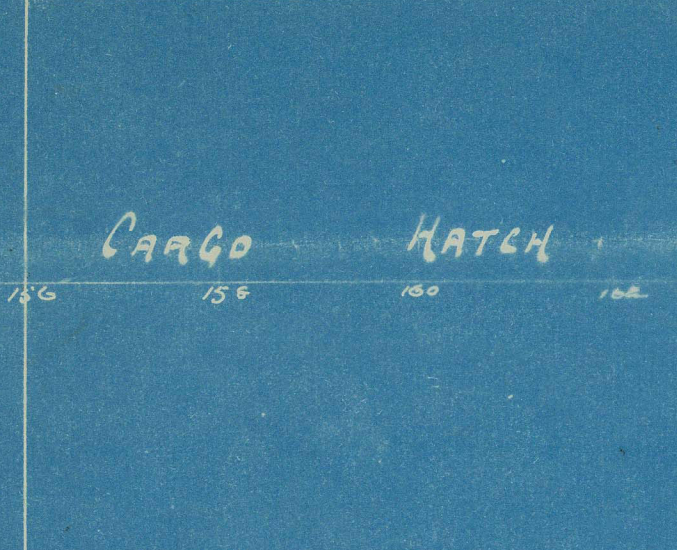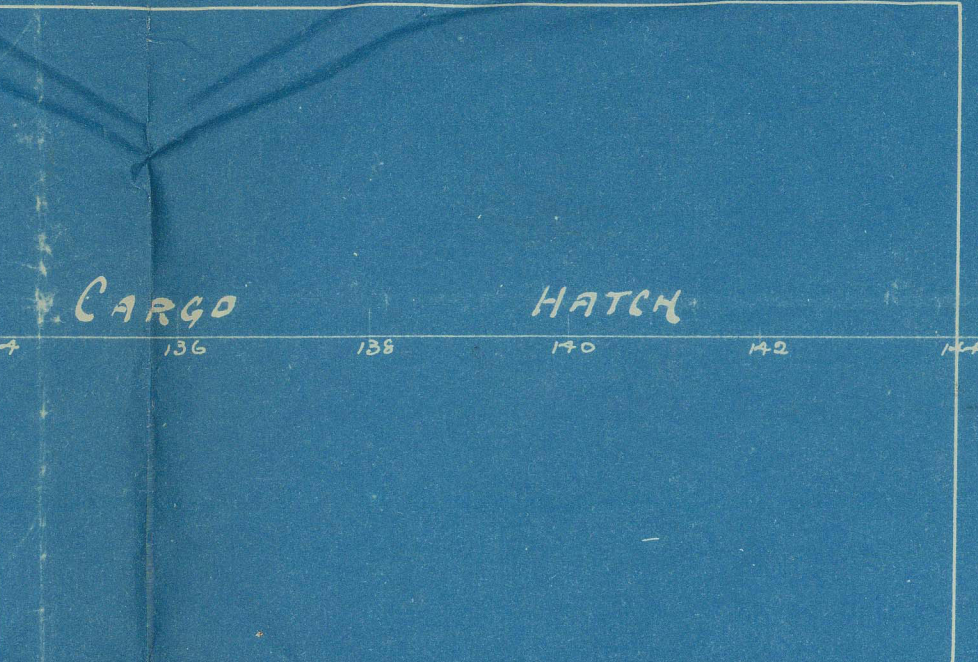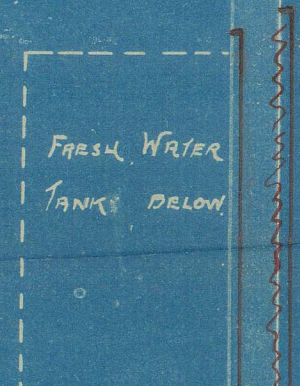



Robert Napier & Sons

No 263 75 "Meravian"

Glasgow Report No. 16720



© 2021

Lloyd's Register  
Foundation