


8.12.87

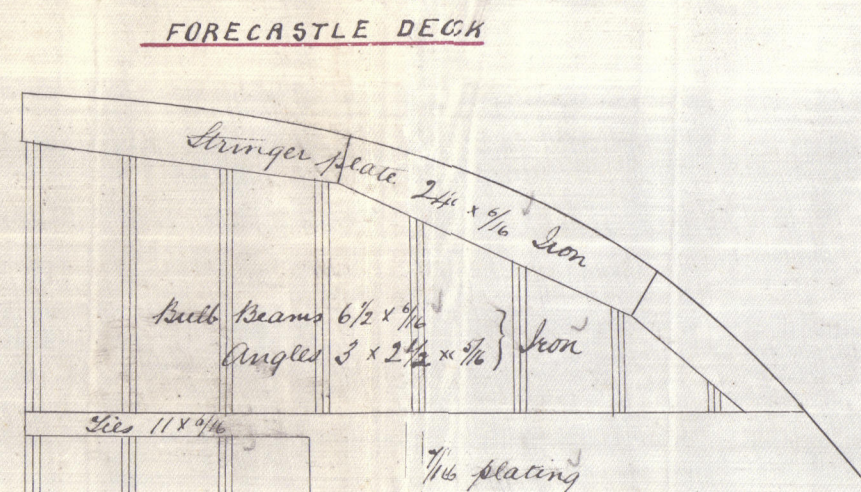

SCALE $\frac{1}{8}$ OF AN INCH = 100'

[illegible]

6th Dec. 1881