

*S. S. Bonnington, Green*

GRK300 - 0021



© 2019

Lloyd's Register  
Foundation

3 2

\*2\*



3 2




Dr to Mr 17/2/82.

S. S. Bonnington, Greenock Report No. 8401

GRK300-0021

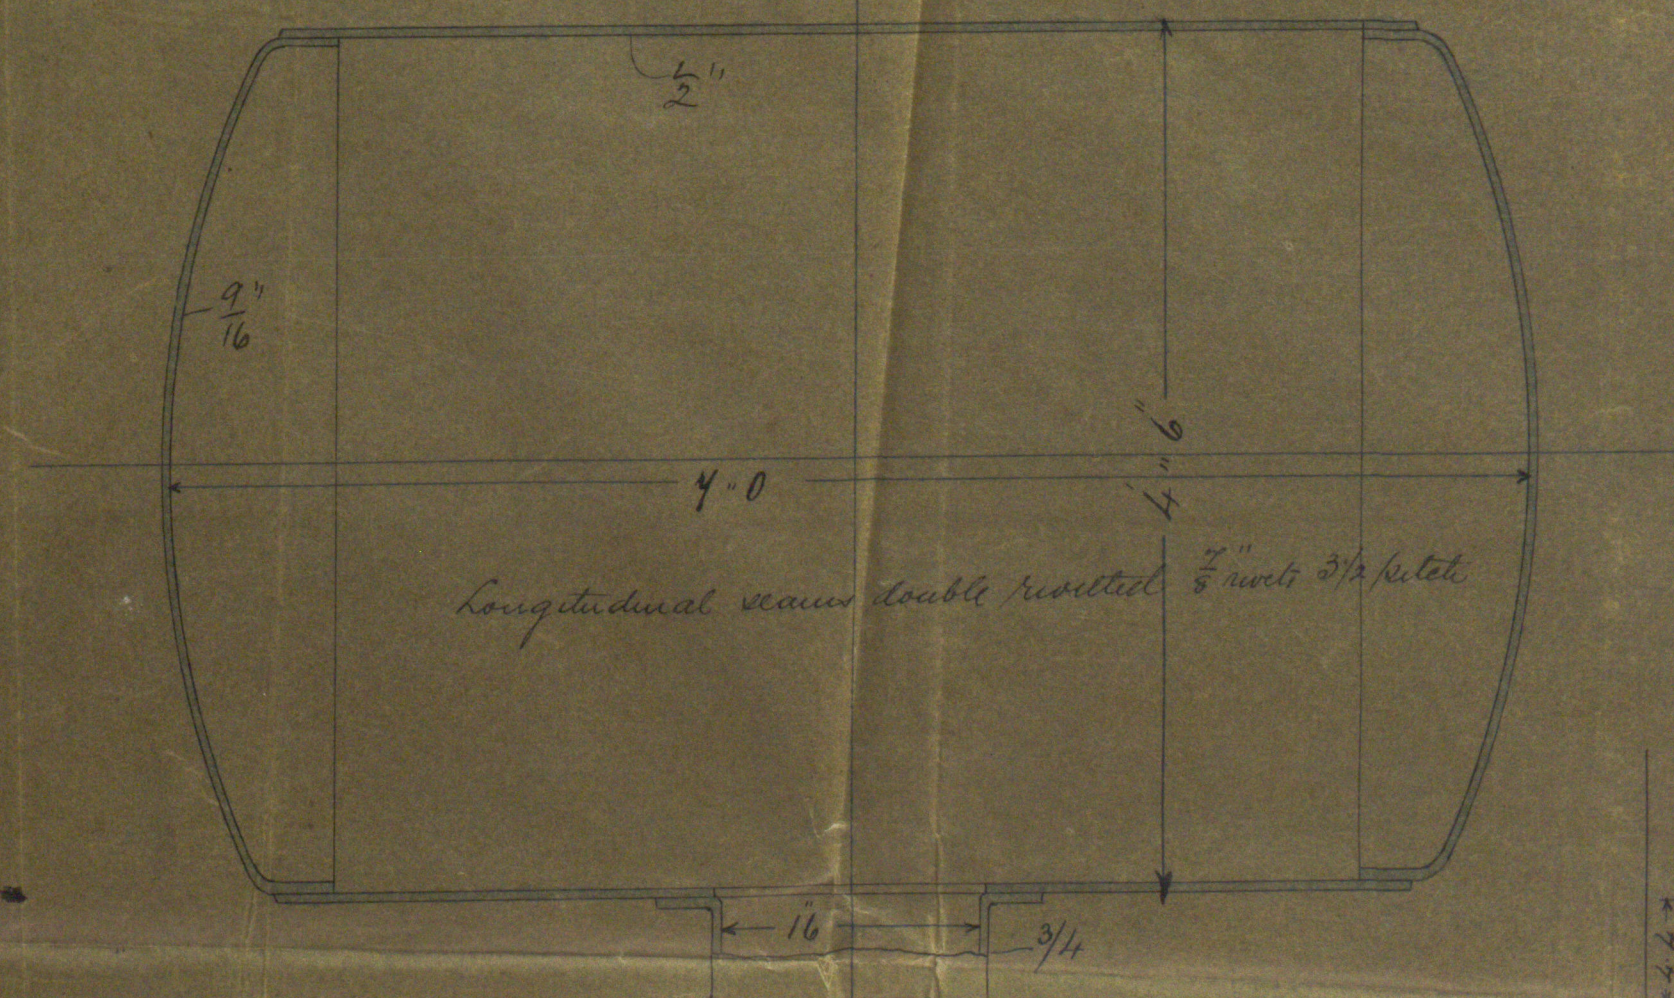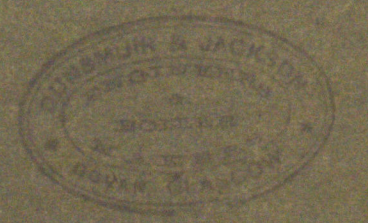


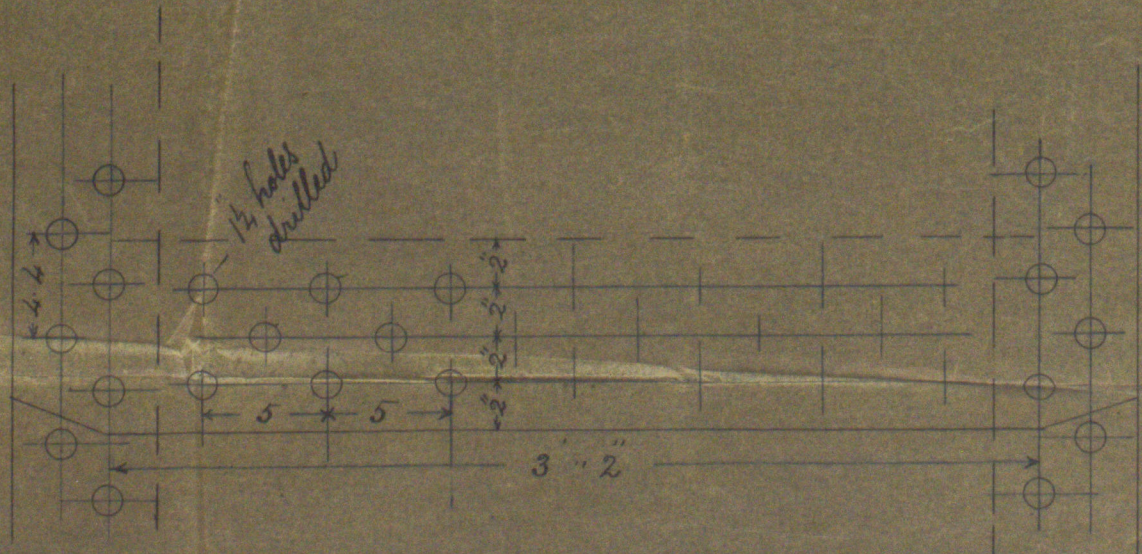

Working Pressure 85 lbs

Tubes 3 1/2 dia x 6' 11" long  
Stay tubes 1 1/2 dia x 6' 11" long  
Plain 3 1/2 dia x 6' 11" long

1/4 second stays  
null in position

Stay stays here

Manhole  
with clamping head

Manhole  
with clamping head

Ex<sup>a</sup> - 122R 16/2/82  
flangew-

Scale 1" = 1 foot

STEEL  
BOILER  
No 38

17/2/82

17/2/82

No 38

GRK300-0021