


SEP 83
CONDO

Dr. to Brk.
19/2/83

Longitudinal Section of S. S. No. 224 N. 228.
Scale $\frac{1}{8}$ inch = 1 foot.

S.S. "Crown of Arragon"
Greenock Report #8546.

REGISTER OF SHIPS
OFFICE
GREENOCK

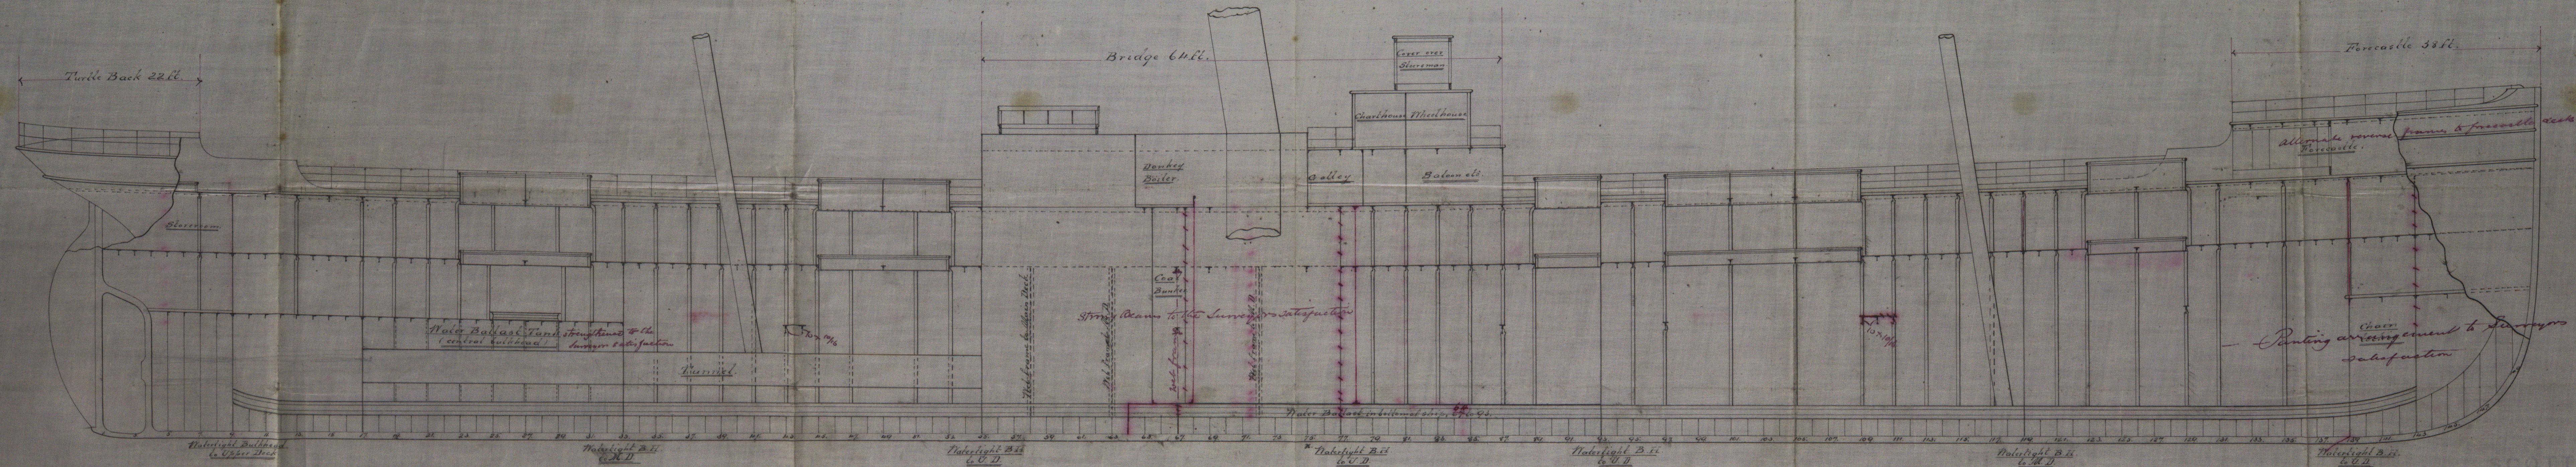

SCOTT & CO.
ENGINEERS AND SHIPBUILDERS
GREENOCK

© 2019
6/2/83

