

# Lloyd's Register of British and Foreign Shipping.

(Received in the London Office, .)

600783  
LONDON

F.

No. 209

## REPORT ON SHIP FORGINGS.

Sir,

I beg leave to report that the undermentioned Forgings, manufactured by  
*Messrs The Darlington Forge Co. of Darlington*  
 for the Vessel No. 228, being built by *Messrs Scott & Co.*  
 of *Greenock,* have been inspected by me in course  
 of being forged and smithed, and found to be, so far as can be seen, *sound and*  
*efficient.*

D.S.  
6/10/83

Mark on Forging.

Lloyd's  
 No. 209  
 9/83  
 206

I am, Sir,

Your Obedient Servant,



*N. Cameron.*

The Secretary,  
 London.

*Sunderland.*

	STERN FRAME.	RUDDER FRAME.	STEM.
Material*		<i>Scrap Iron</i>	
How made		<i>Forged</i>	
Dimensions	<i>Not seen</i>	<i>7 3/4" x 3 3/4"</i>	<i>Not seen</i>
Progress on Inspection		<i>Forging &amp; smithing</i>	
Dates when Inspected		<i>Aug 22-24-29 Sept 4-13-14<sup>th</sup></i>	

SKETCHES OF FRAMES SHEWING POSITION AND DESCRIPTION OF WELDS.

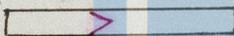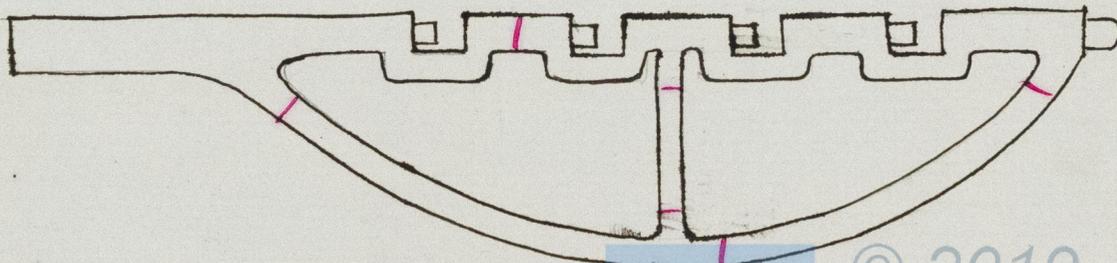

*Welds in Red*

© 2019

Lloyd's Register  
 Corporation

\* If of iron, state whether scrap or puddled iron.