

14:12:83

Classed 100. A. I.

ships Brownrigg and  
"Falls of Cain"  
Greenock Report No. 842


1/2 Girth	42.4
1/2 Breadth	20.9
Depth	<u>26.85</u>

$$\begin{array}{r} 26.85 \\ 90.15 = 1^{st} \text{ fl} \end{array}$$
  
$$\begin{array}{r} 280.43 = \text{length.} \\ 25805.25 = 2^{nd} \text{ fl} \end{array}$$
  
$$\begin{array}{r} 1720.36 = \frac{1}{10} \text{ added for Prop} \\ 27525.79 = \text{Equipment etc} \end{array}$$

Under 11 Depths and 7 breadths

Equipment

			cats
1 Bowser Anchor	excd 2 stock		40
1       do	do		58
1       do	do		36
1 Stream	do		12
1 Hedge	do		6
1       do	do		3
270 Fathoms	of	2 1/2" steel chain	
90       do		2 1/2" stream do	
90       do		12 galval wire	
90       do		11 qt. warps	

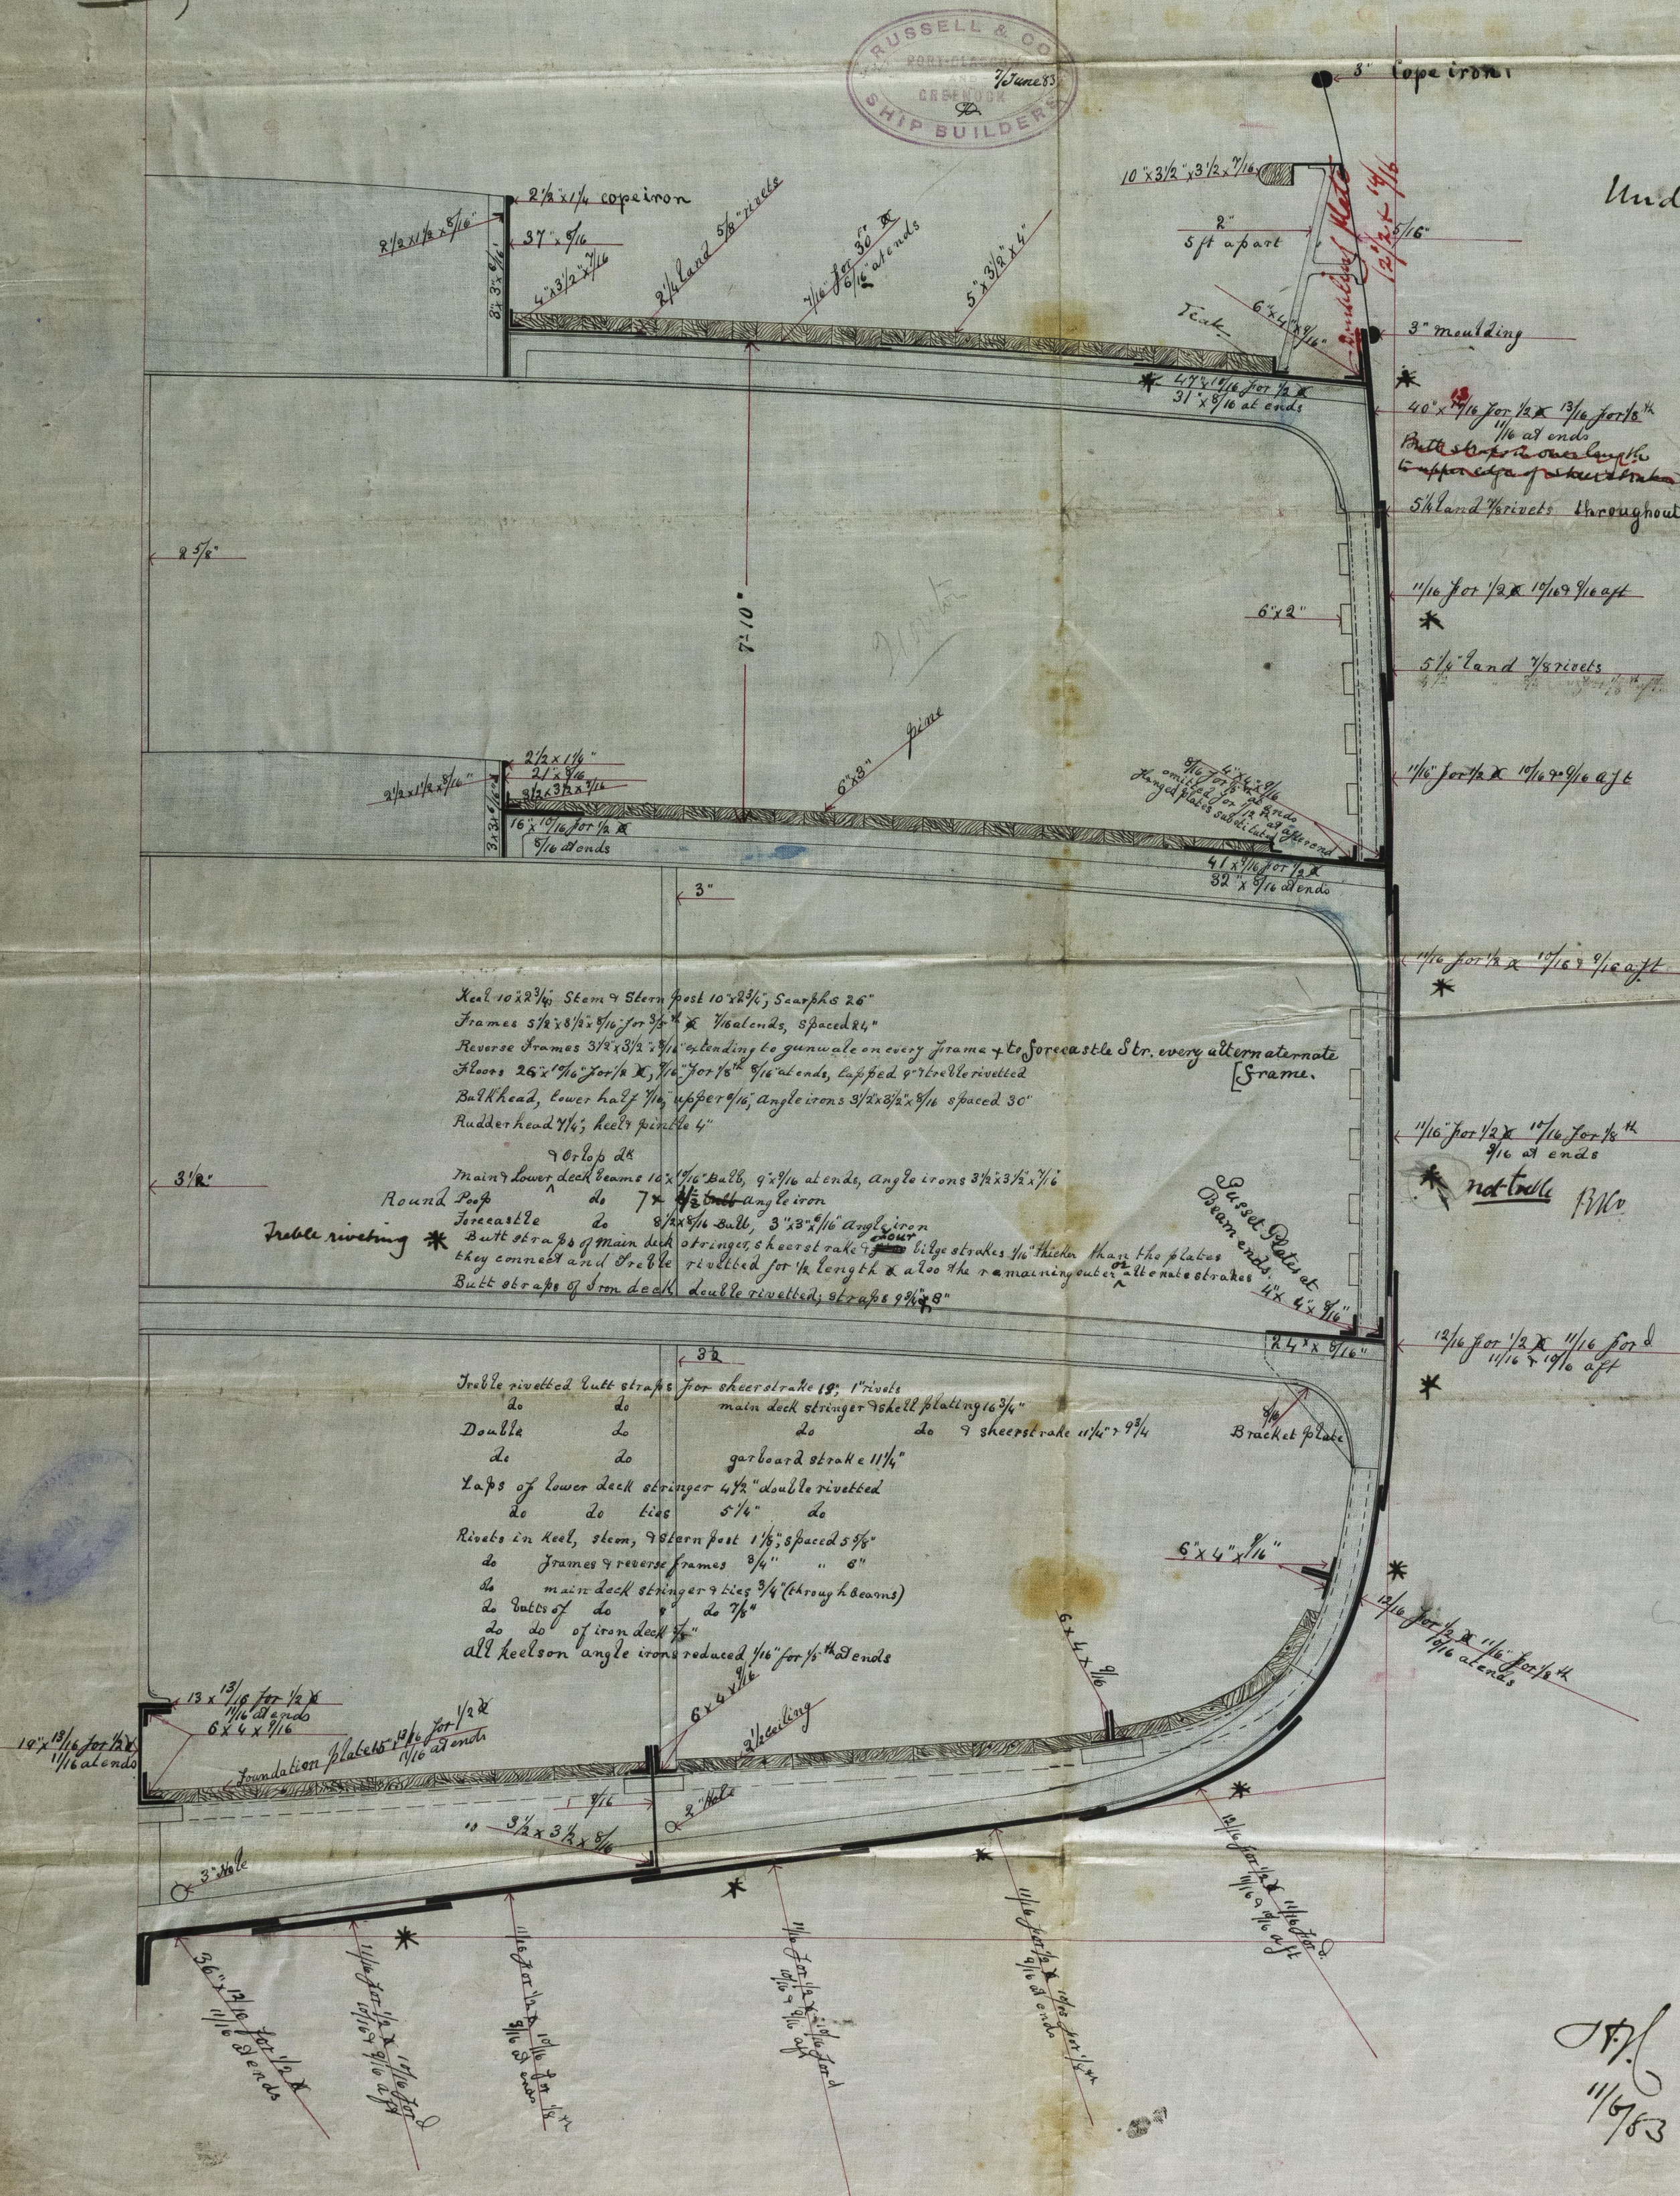

11/6/83