

# Lloyd's Register of British and Foreign Shipping.

(Report on Vessel No. \_\_\_\_\_ Port \_\_\_\_\_)

No. 1048

## SHIP FORGINGS OR CASTINGS.

I have to report that the undermentioned Iron ~~or Steel~~ Forgings ~~or Castings~~, manufactured by The Lancefield Forge Co of Glasgow for the Vessel No. 92, being built by Messrs Murdoch & Murray of Port Glasgow have been inspected by me as set forth below, and found to be, so far as can be seen, sound and efficient


Work on Forgings.

Lloyd's  
No. 1048  
G.N.

George Newcomb  
Glasgow 25/5/85.

	STERN FRAME.	RUDDER FRAME.	STEM & Keel
Material*	Scrap iron	/	Scrap iron
Made	Forged		Forged
Dimensions	6 1/2 x 3 3/4		Stem 6 1/2 x 1 7/8 Keel 7/4 x 1 7/8
Progress on Inspection	Forging & smithing		Forging & completed
Dates when Inspected	4. 7. 12. 14. 18. 20. 23/5/85.		20. 23. 28. 30/4/85. 4/5/85.

SKETCHES OF FRAMES SHEWING POSITION AND DESCRIPTION OF WELDS OF FORGINGS, OR PARTICULARS OF TESTS APPLIED TO CASTINGS.

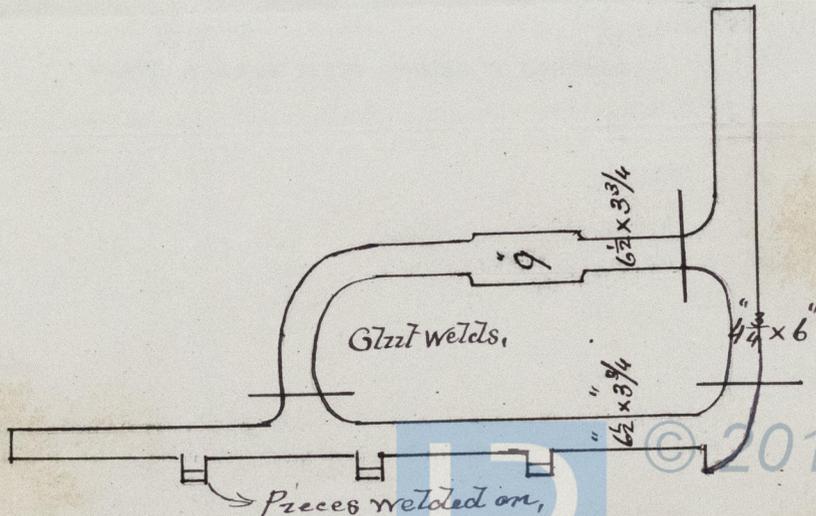

\* If of Iron, state whether scrap or puddled Iron.