


dr. to G.K. 30/6/85

S.S. "Captain McEwen";
G.K. Report No. 9020

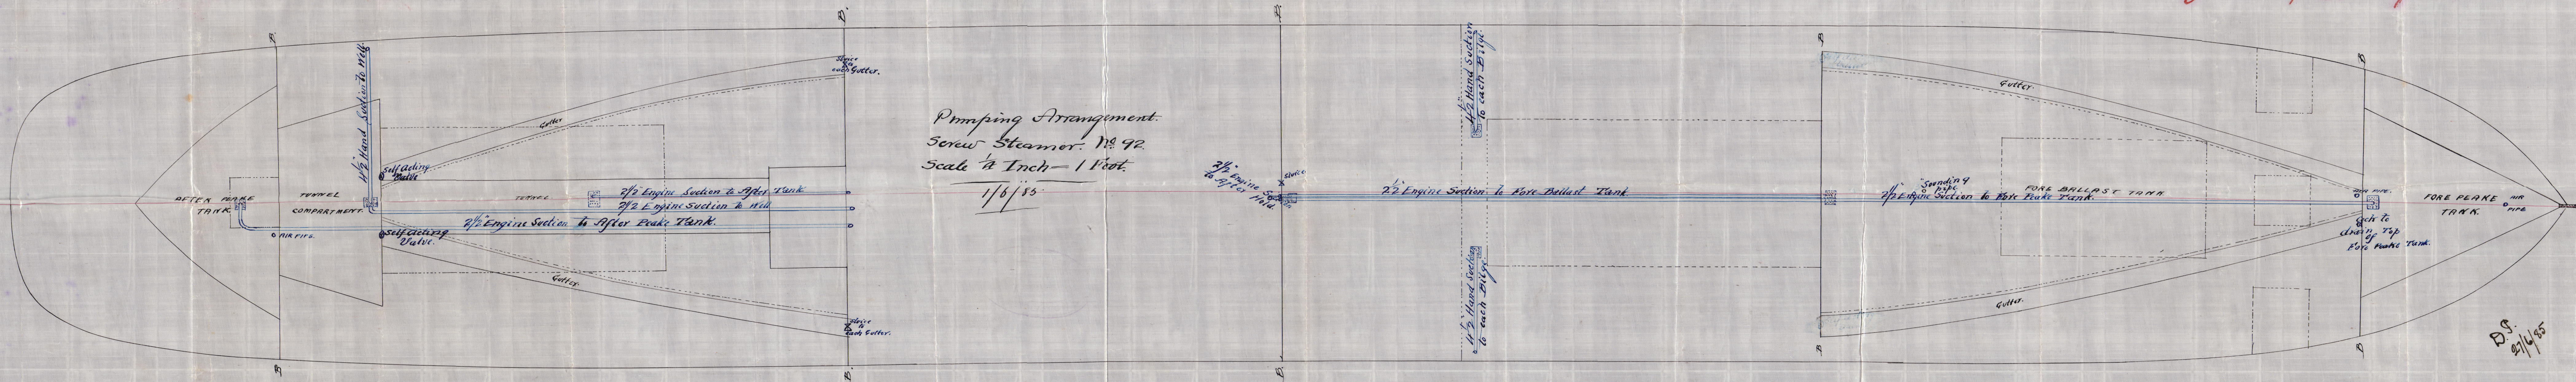

D.S.
27/6/85