


MIDSHIP SELECTION

No 283

:296, 297. 306 309. 315.
 5.8.91. 4.12.91. 9.2.92. 22.4.92.

SCALE $\frac{1}{2}$ INCH=ONE FOOT

Registered Dimensions 236.0 x 36.0 x 21.72

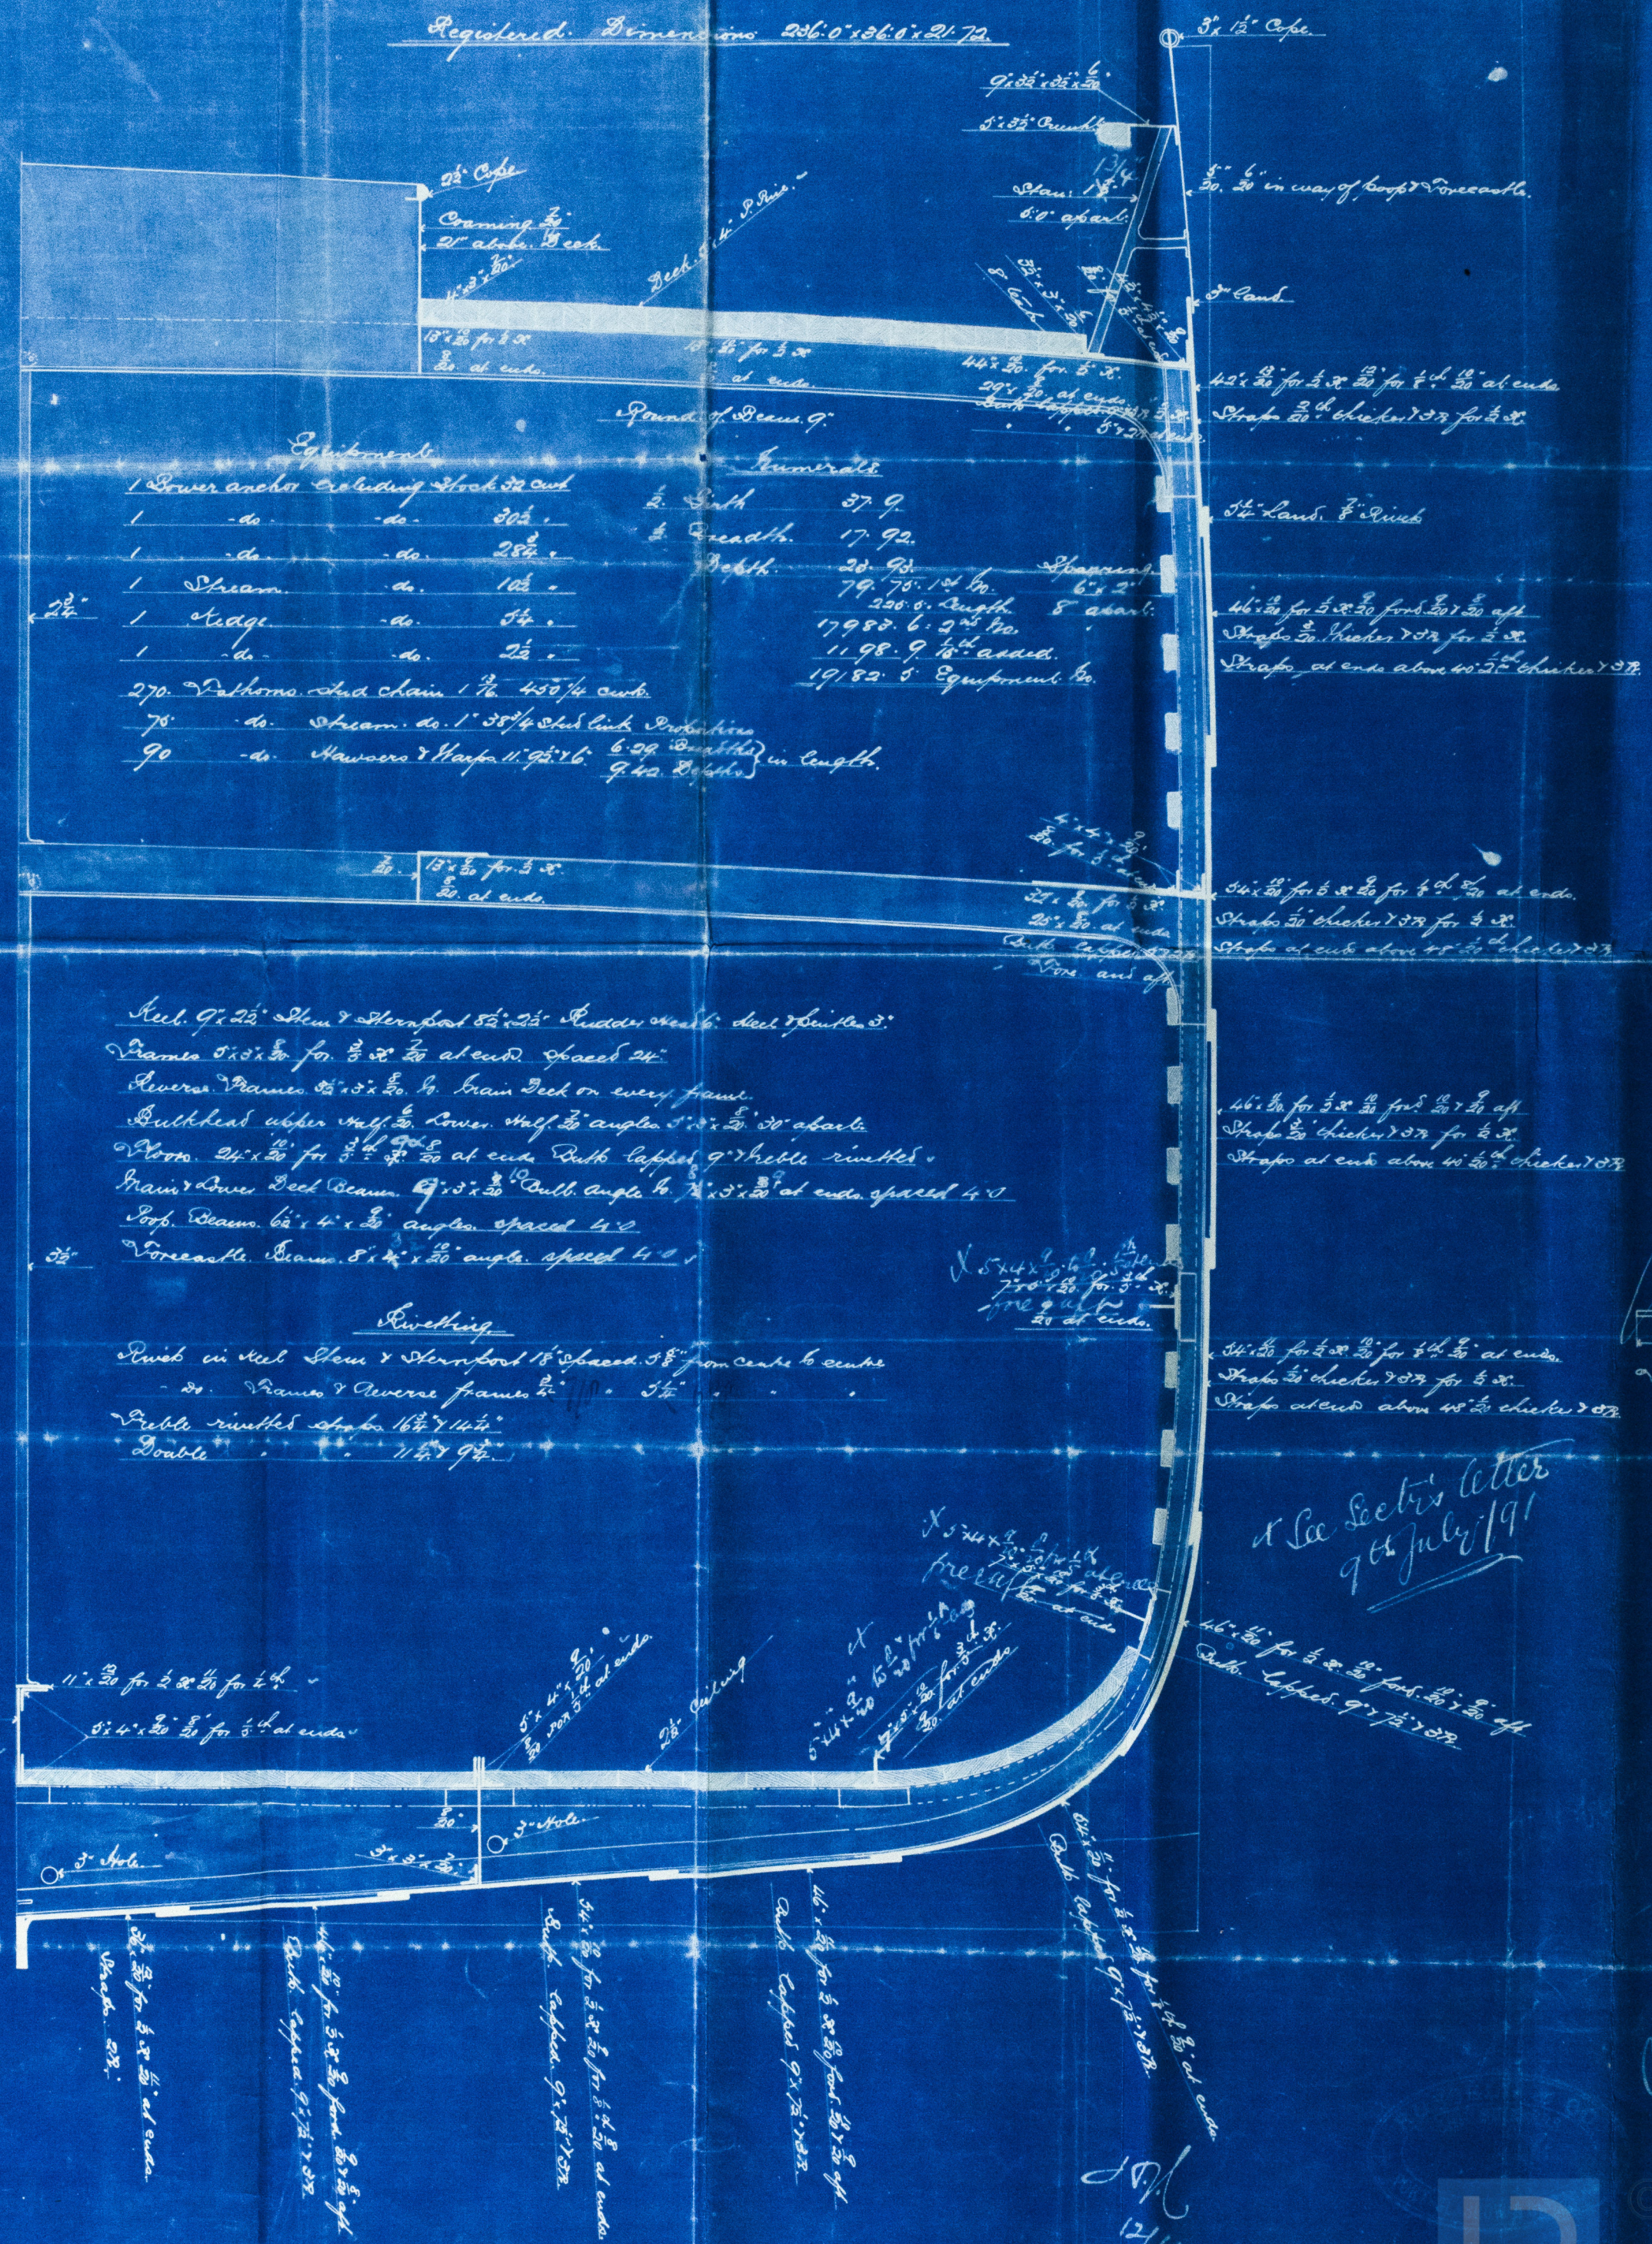

Three acle.
 Slings 30" x 60" to 20" x 60".
 Side Slating 60".
 N. S. Slates 10" x 60".
 Angles 24" x 24" x 60".
 Pillars 24".
Top.
 Side Slating 60".
 N. S. Slates 14" x 60".
 Angles 24" x 24" x 60".
 Pillars 24".

Expenses		Summ.
1	Lower anchor including hook 32 cwt	£. 5th 37 9
1	do do 30½ "	£. 6th 17 9
1	do do 28½ "	£. 7th 28 9
1	Stream do 10½ "	79 7
1	Studge do 5½ "	20
1	do do 2½ "	179 80
		11 98
270	Pathons and chain 1 3/4 450 1/4 cwt.	191 82
78	do Stream do 1 3/4 38 1/4 shed link Pathons	
90	do Hawsers & Harpa 11 9 1/2 16 9 42 8 Pathons } in length	


Humeralis

sk	37.9.	
adth.	17.92.	
hth.	28.92.	
	79. 70. 100 cm.	Span
	220.0. Length	6"
	179.82. 6. 3 1/2 in.	8 in
	11.98. 9 1/2 in.	
	ad. as ad.	
	191.82. 5 Equipment. Co.	

Keel. $7\frac{1}{2} \times 2\frac{1}{2}$ Stem & sternpost $5\frac{1}{2} \times 2\frac{1}{2}$ Pudding mark. deck, 3 in. 3 in.
Frames $5 \times 5 \times 5$ for $3 \times 3 \times 3$ at ends spaced 24"
Revers. Frames $5\frac{1}{2} \times 5 \times 5$. b. main Deck on every frame.
Bulkhead upper half 5×5 lower half 3×5 angles $5 \times 5 \times 5$ 30" apart
Floors 24×50 for $3 \times 5 \times 5$ at ends Bulk lapped 9" double rivetted.
Main & inner Deck beams $9 \times 5 \times 5$ Bulk angle b. $4 \times 5 \times 5$ at ends spaced 4 ft
Pop. Beams $6\frac{1}{2} \times 4 \times 5$ angles spaced 4 ft
Forecastle Beams $8 \times 4 \times 5$ angles spaced 4 ft

Riveting
Ribs in Keel Stem & Sternpost 15" spaced 58" from center to center
" " Frames & Reverse frames $\frac{1}{2}$ " " 54"
Ribs rivetted about 16 1/2" & 14 1/2"
Double " " 11 1/2" & 9 1/2"

See Sect's letter
9th July/91

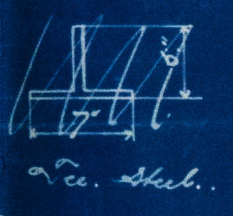

J.D.H.
12/6/91

"Earl Cadogan":
Greenock Report No.

614320-0227



© 2019

Lloyd's Register
Foundation