

"Carfadogan"

Lloyd's Register of British and Foreign Shipping.

(Report on Vessel No. 10548 Port Greenock.)

Greenock

No. 1965a

SHIP FORGINGS OR CASTINGS.

The words FORGINGS or CASTINGS, IRON or STEEL, should be struck out as may be required.

I have to report that the undermentioned Iron or Steel Forgings or Castings, manufactured by Messrs R S Bagnall & Sons of Wylton for the Vessel No. 286, being built by Messrs Russell & Co. of Greenock have been inspected by me as set forth below, and found to be, so far as can be seen, sound

Mark on Forgings.


Lloyd's
No. 1965a
No. 6

Wm Cameron


Sunderland
16/9/91

	STERN FRAME.	RUDDER FRAME.	STEM.
Material*	<u>Scrap iron</u>	<u>Scrap iron</u>	<u>Scrap iron</u>
How made	<u>Forged</u>	<u>Forged</u>	<u>Forged</u>
Dimensions	<u>8 1/2 x 2 1/2"</u>	<u>6" x 3"</u>	<u>8 1/2 x 2 1/2"</u>
Progress on Inspection	<u>Forged & Smithed</u>	<u>Forged & Smithed</u>	<u>Forged</u>
Dates when Inspected	<u>June 23-30 July 9-20/91</u>	<u>July 25-31 Aug 14-24/91</u>	<u>July 20/91</u>

SKETCHES OF FRAMES SHEWING POSITION AND DESCRIPTION OF WELDS OF FORGINGS, OR PARTICULARS OF TESTS APPLIED TO CASTINGS.

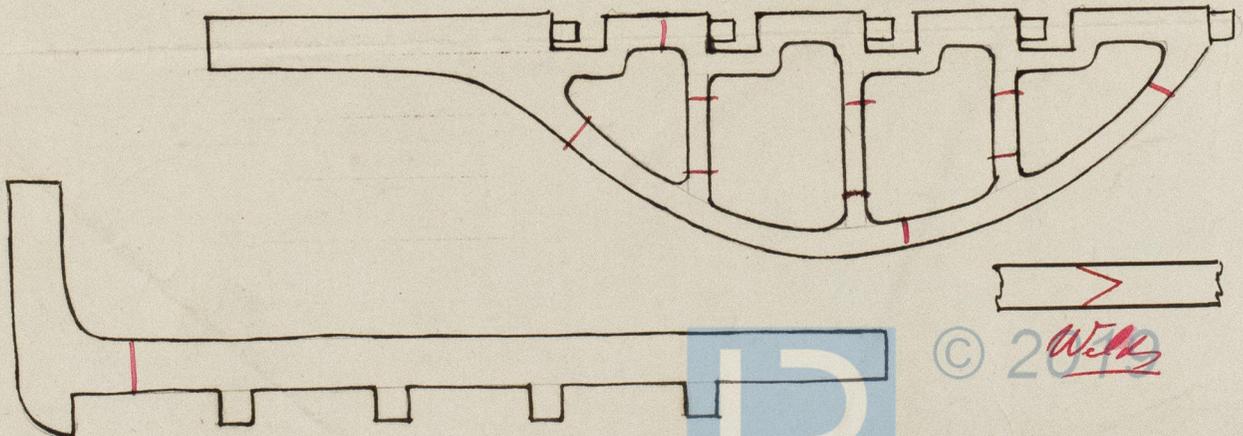

* If of Iron, state whether scrap or puddled Iron.

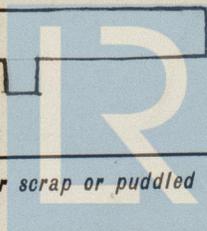

© 2013

Lloyd's Register Foundation

1965

Russell & Co. No 286
Rpt Forgings. H. R. S. P


✓

SHIP FORGINGS OR CASTINGS

[Faint, mostly illegible handwritten text, likely bleed-through from the reverse side of the page.]

3110000


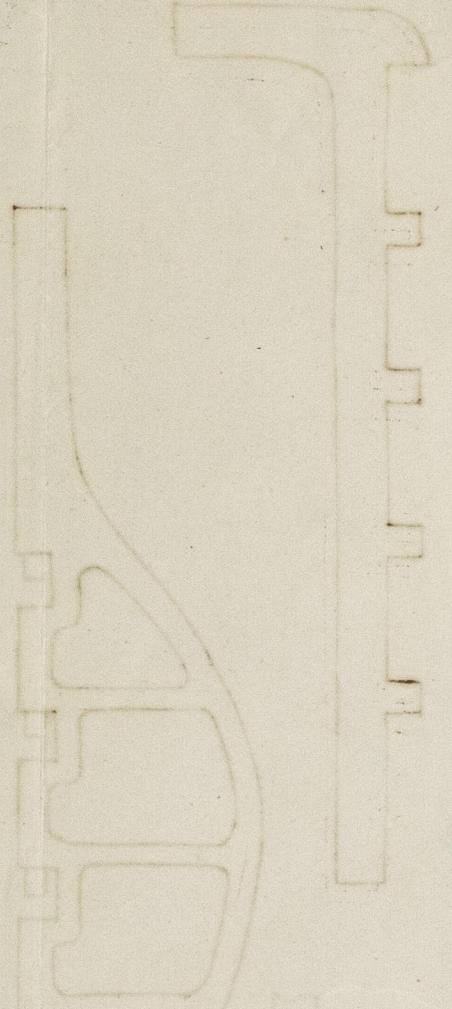

© 2019
Lloyd's Register
Foundation