


— Midship Section —  
— Steel Barque No 108 —

"Almora"

— Dimensions 249'0" x 39'0" x 24'5" m<sup>d</sup> —  
22' 11 1/2" Hold to Ceiling

Jrk. Ref. No. ....  
Amended section showing  
shell plating within Hull  
widths; as required per  
Secty's letter of 7.12.92

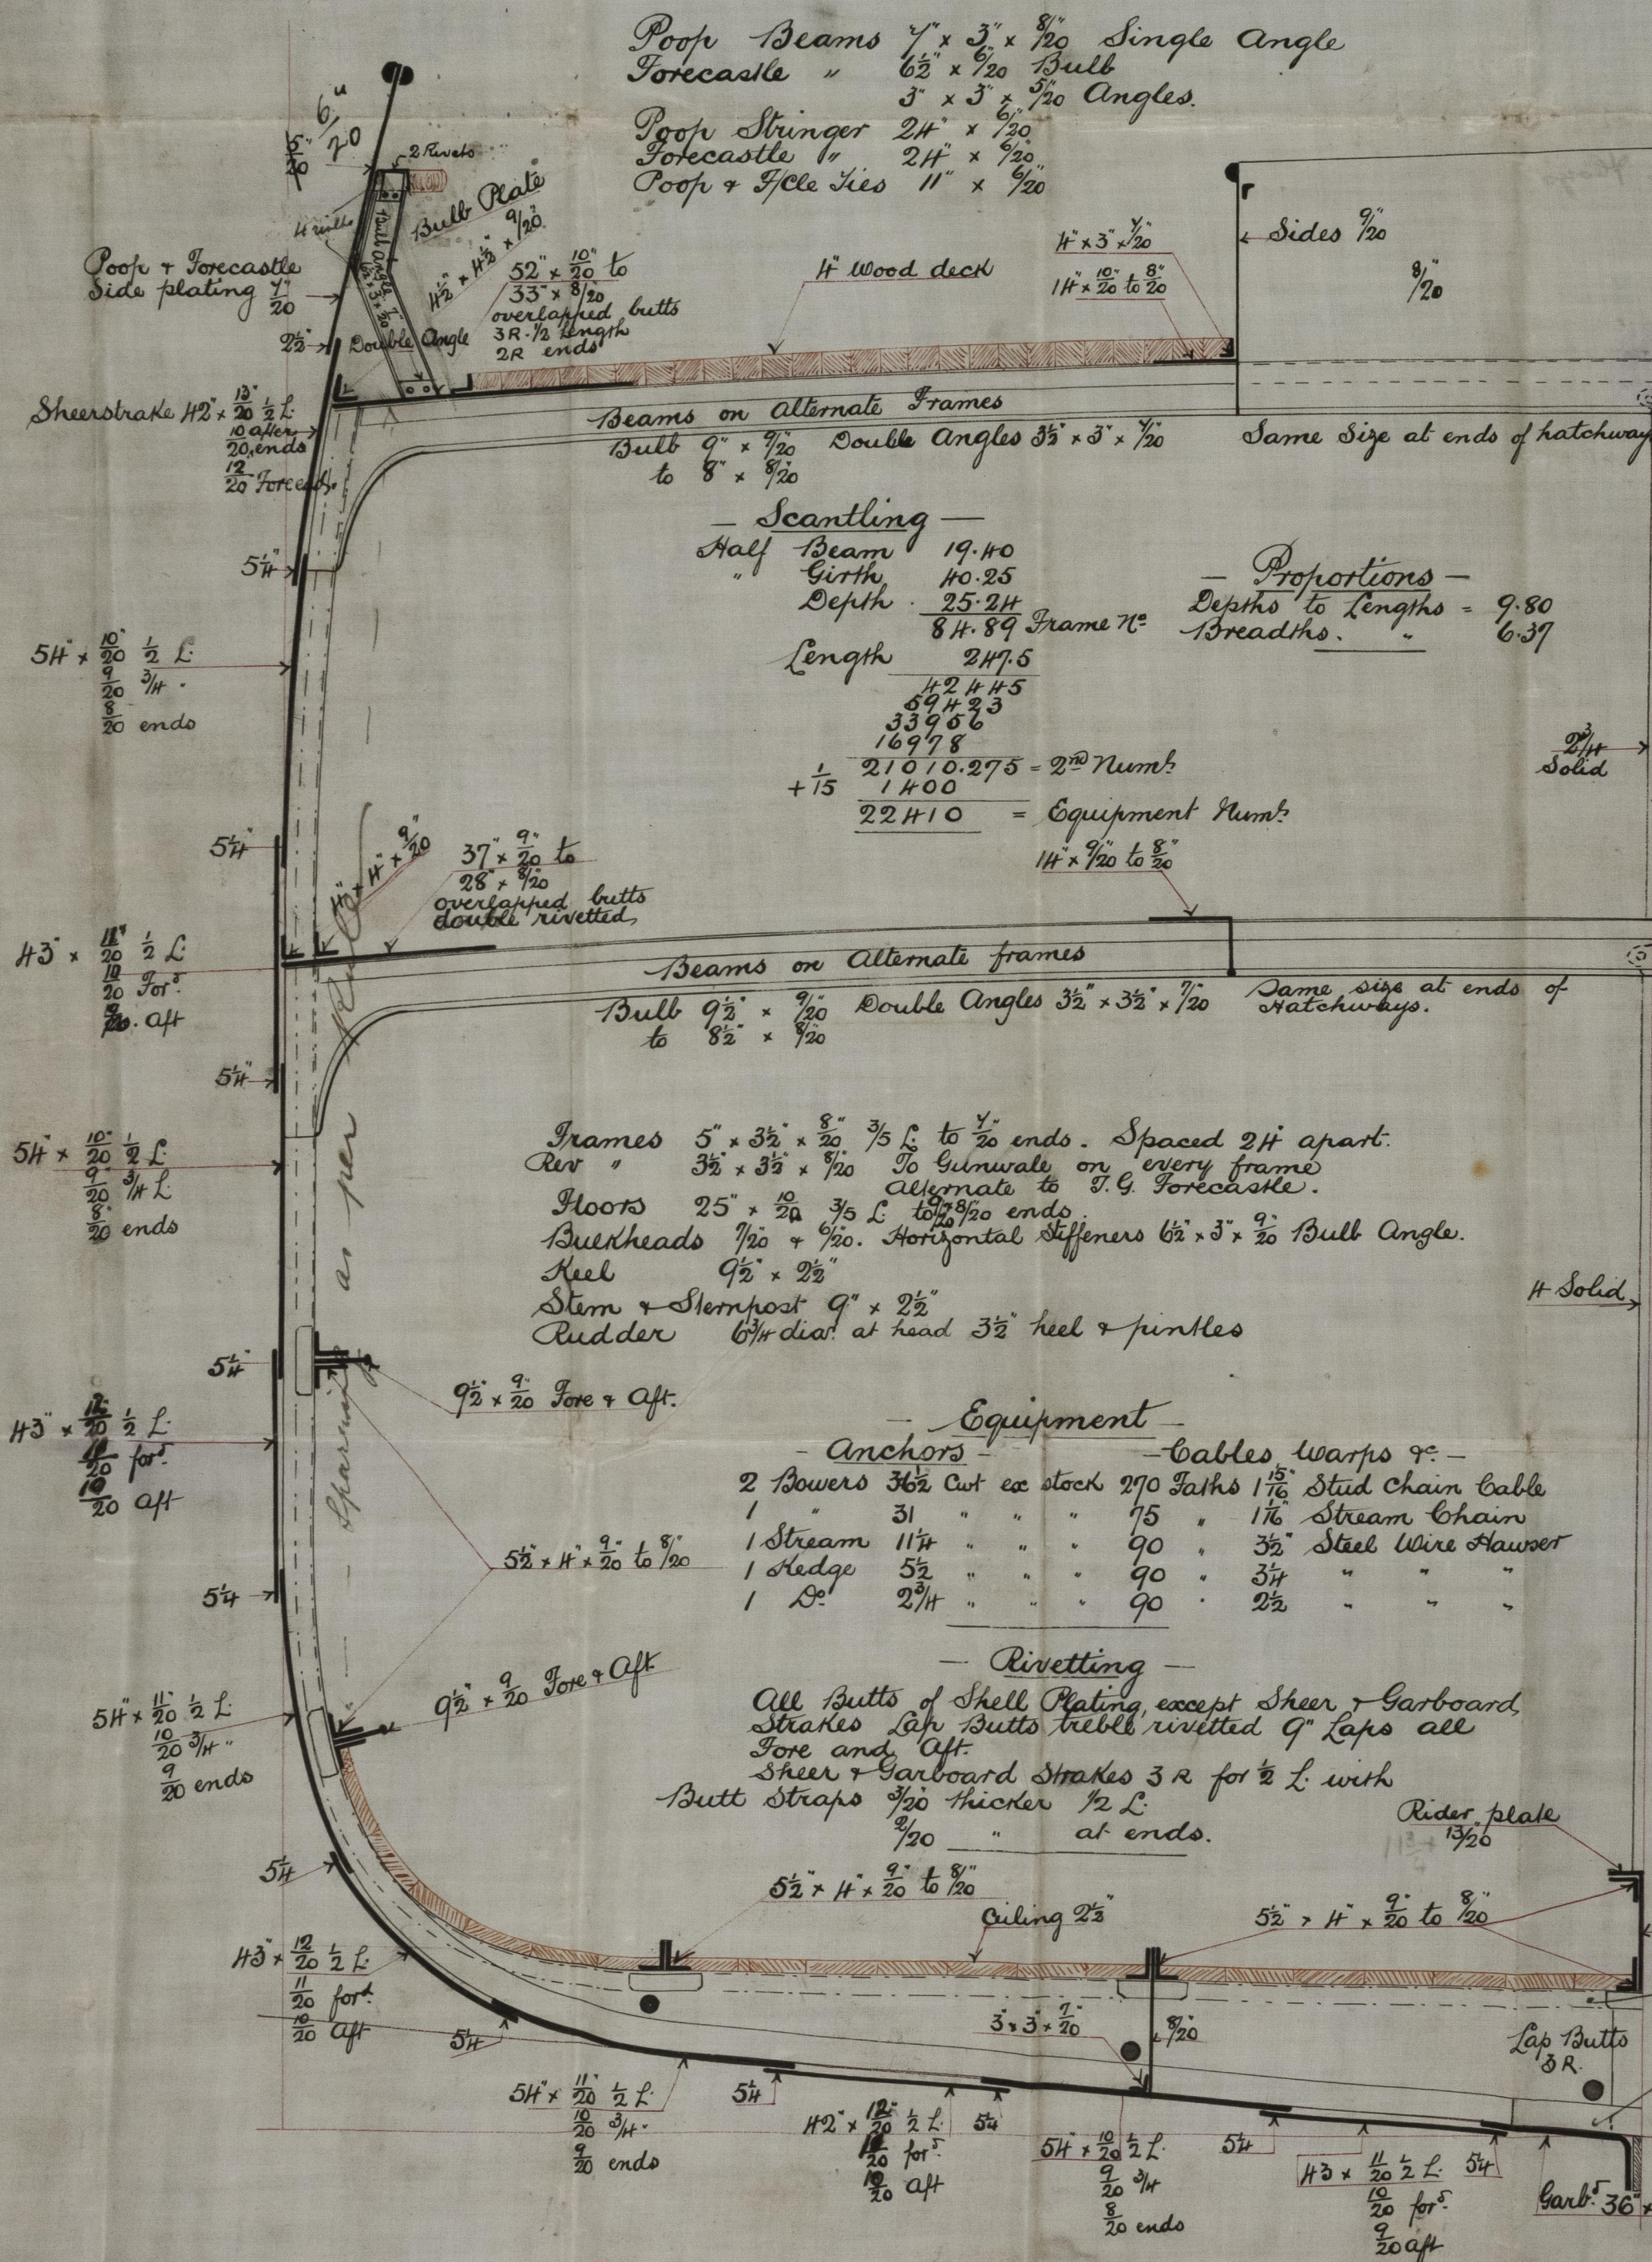

— Scale 1/2 Inch = One Foot. —



Lloyd's Register  
Foundation  
APR 2021



Wm Hamilton Hoy's

108.

"*Aurora*"

Greenock Rep. No. 10813.

GRK324-0166



© 2021

Lloyd's Register  
Foundation