





Grk. Rpt. No.

Dimensions 249' 0" x 39' 0" x 24.5 in^d —
22' 11²/₄" Hold to Ceiling

See amended
Section showing widths
of shell plating as fitted
as required per Specs 7.12.92

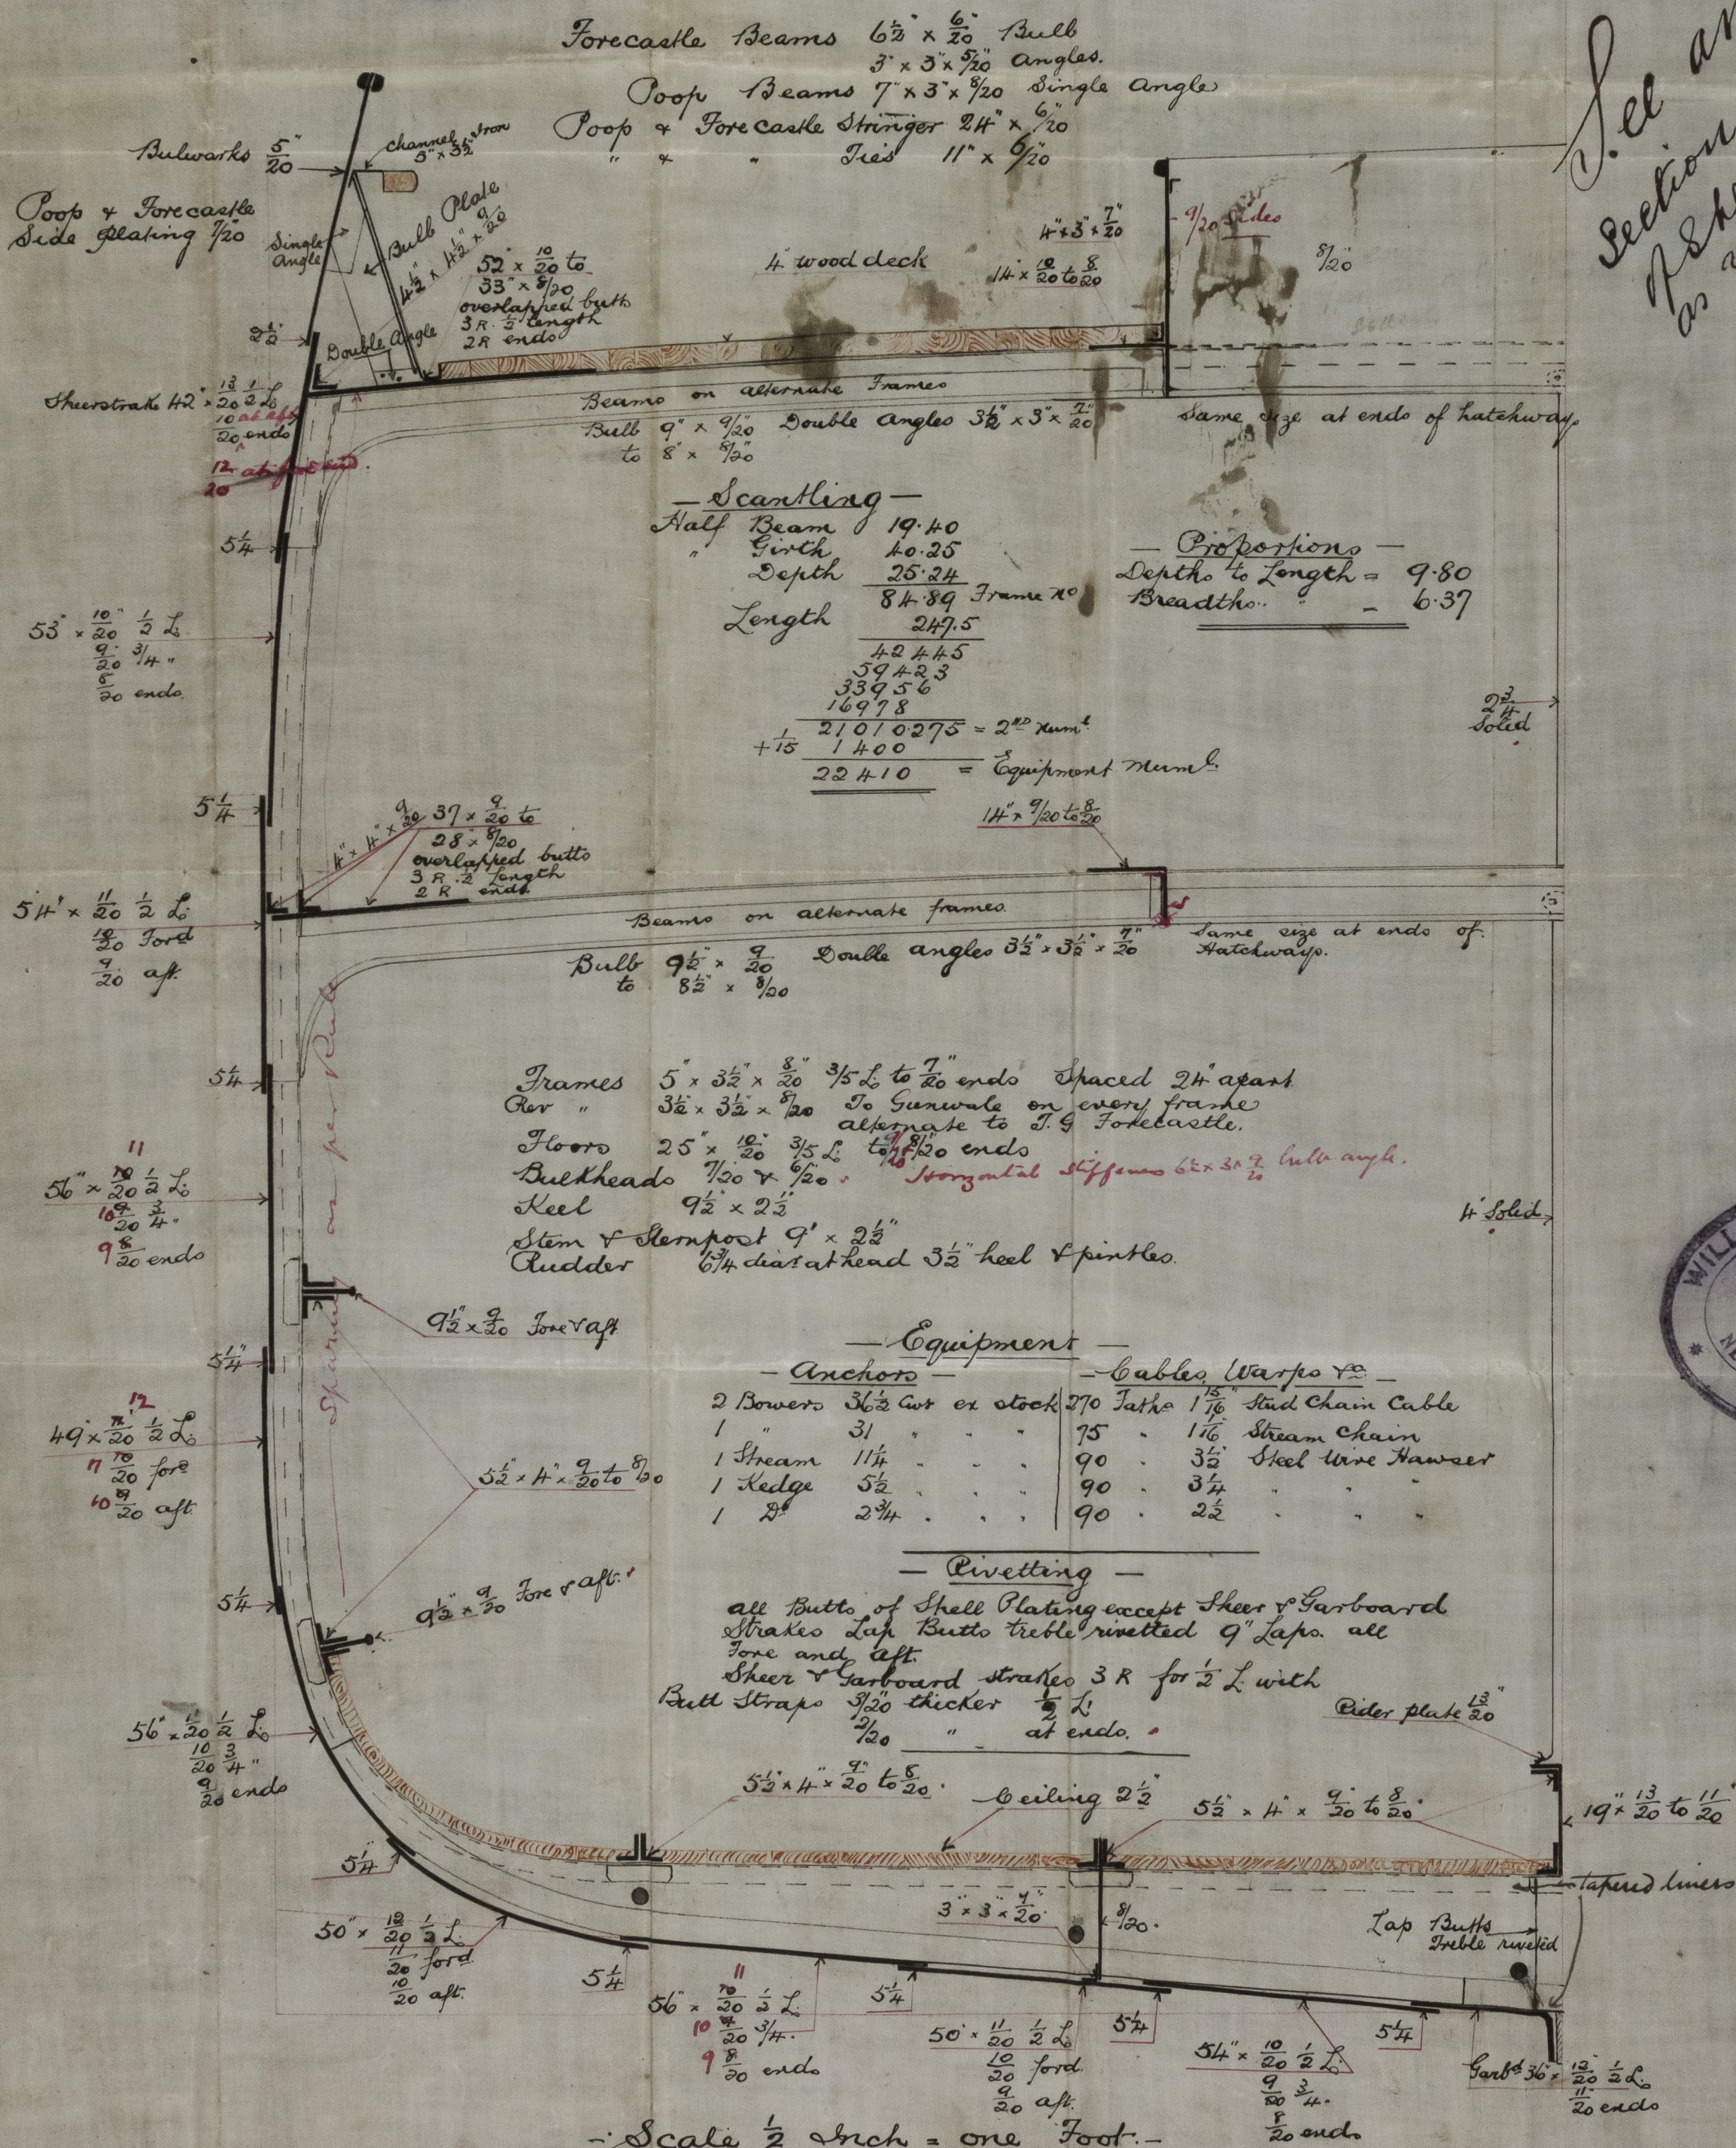

Wm Hamilton & Co 108.

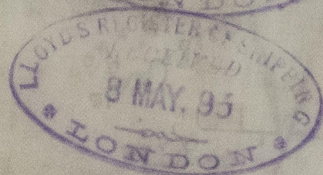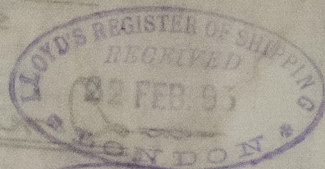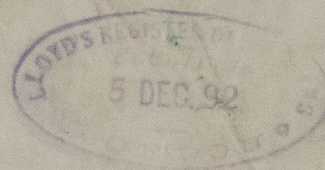

© 2021

Lloyd's Register
Foundation

GRK324-0167