

Section of
Side

Russell & Co's

No 371
Langbank.

REGISTER OF SHIPPERS
RECEIVED
4 DEC. 94
LONDON

LOYD'S REGISTER OF SHIPPERS
RECEIVED
13 DEC. 94
LONDON

fls. 13992

LOYD'S REGISTER OF SHIPPERS
RECEIVED
21 OCT. 93
LONDON

GRK 332-0083

REGISTER OF SHIPPERS
RECEIVED
13 DEC. 94
LONDON




© 2019

Lloyd's Register
Foundation

8.12.94
13.12.94



Section of Side
S. S. No. 371
Scale $\frac{1}{2}$ " = 1 Foot

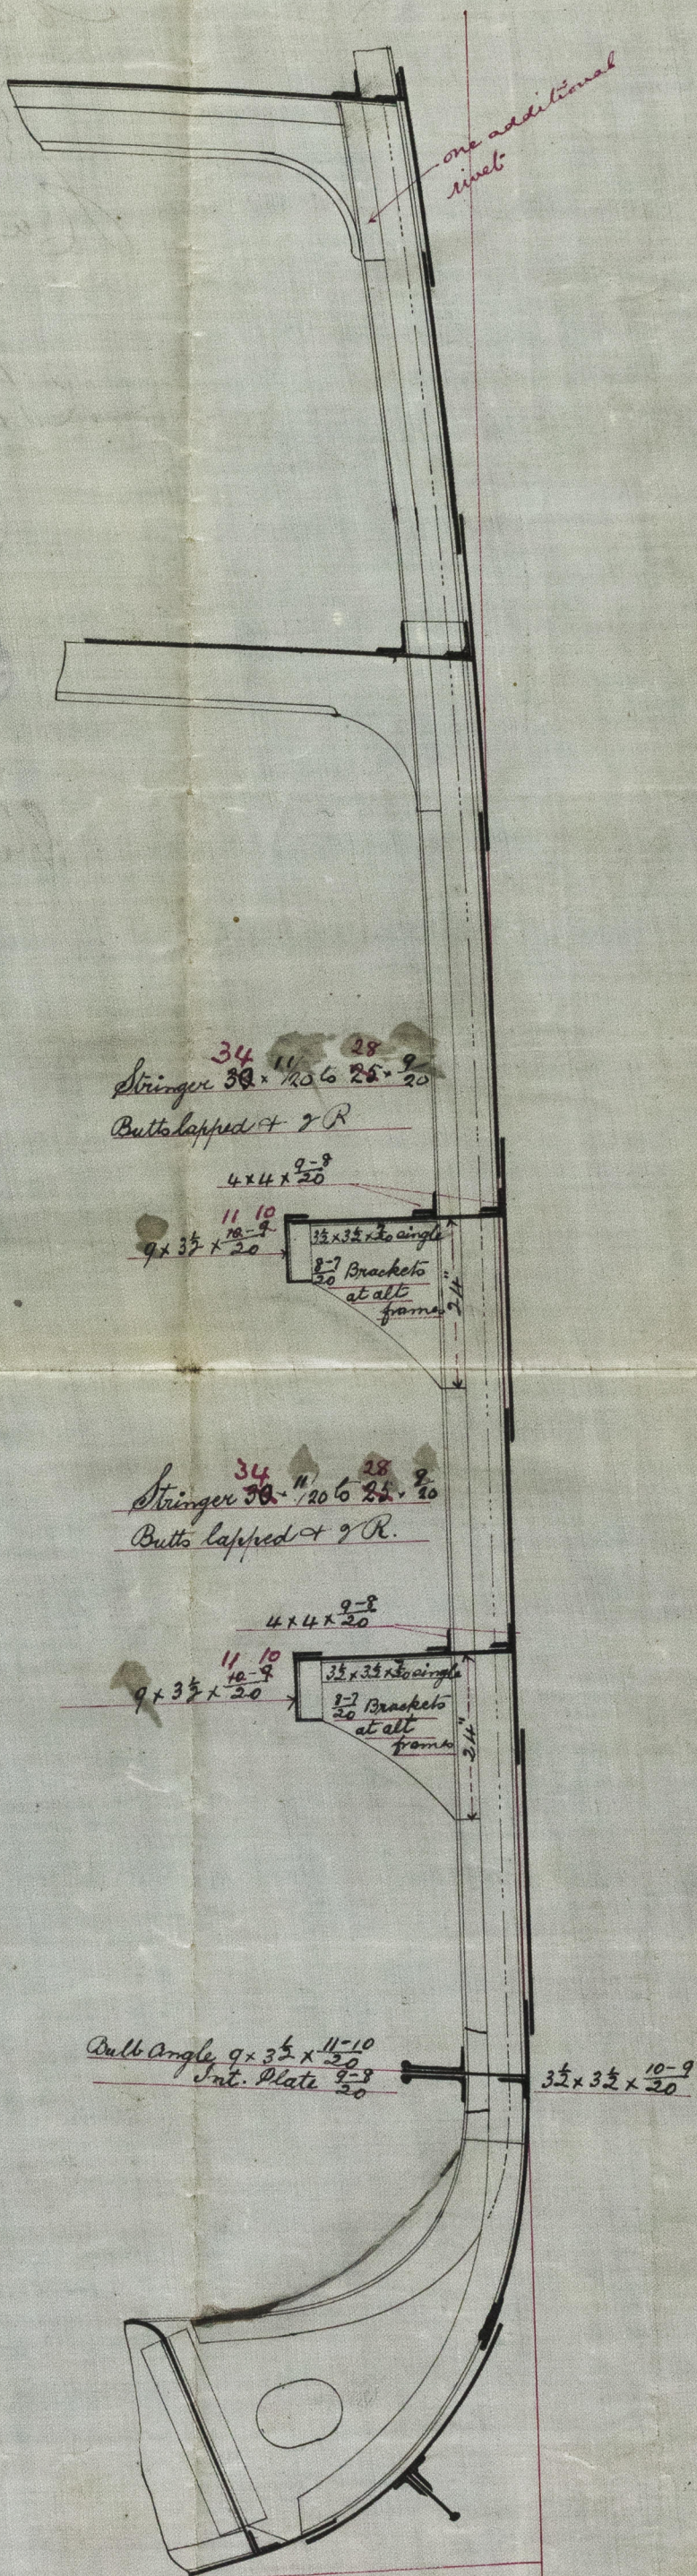

18m
8/12/94

J.T.L.
13/12/94



© 2019

Lloyd's Register
Foundation

GRK332-0083