

Lloyd's Register of British and Foreign Shipping.

(Report on Vessel No. 11463 Port Greenock
pr Barullo)No. 5213 SHIP FORGINGS OR CASTINGS.

I have to report that the undermentioned Iron or Steel Forgings or Castings,
 manufactured by Mess Robt Kerr & Sons
 of Glasgow for the Vessel No. 521, being built
 by Mess A Rodger & Co of Port Glasgow
 have been inspected by me as set forth below, and found to be, so far as can be seen,
Sound & efficient

Mark on Forgings.


Lloyd's
 No. 5213
 W H

William Hamilton

Glasgow
24/4/96

	STERN FRAME.	RUDDER FRAME.	STEM.
Material* ...		Scrap iron	
How made ...		Forged	
Dimensions ...		42 x 12 1/2	
Progress on Inspection		Forging & smithing	
Date when Inspected		15 to 24/4/96	

SKETCHES OF FRAMES SHOWING POSITION AND DESCRIPTION OF WELDS OF FORGINGS, OR PARTICULARS OF
 TESTS APPLIED TO CASTINGS.

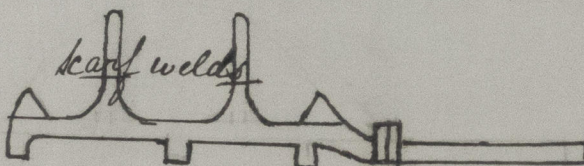

Fee (if any chargeable) £ : :

To be paid at



© 2021

Lloyd's Register
Foundation