



28.2.96


== STERN BRACKET ==

== T.S.S. Nos 320 & 321 ==

== SCALE 1/2" TO 1' FOOT ==



Brackets as made
6 1/2" x 2 1/2" x 2 1/2"

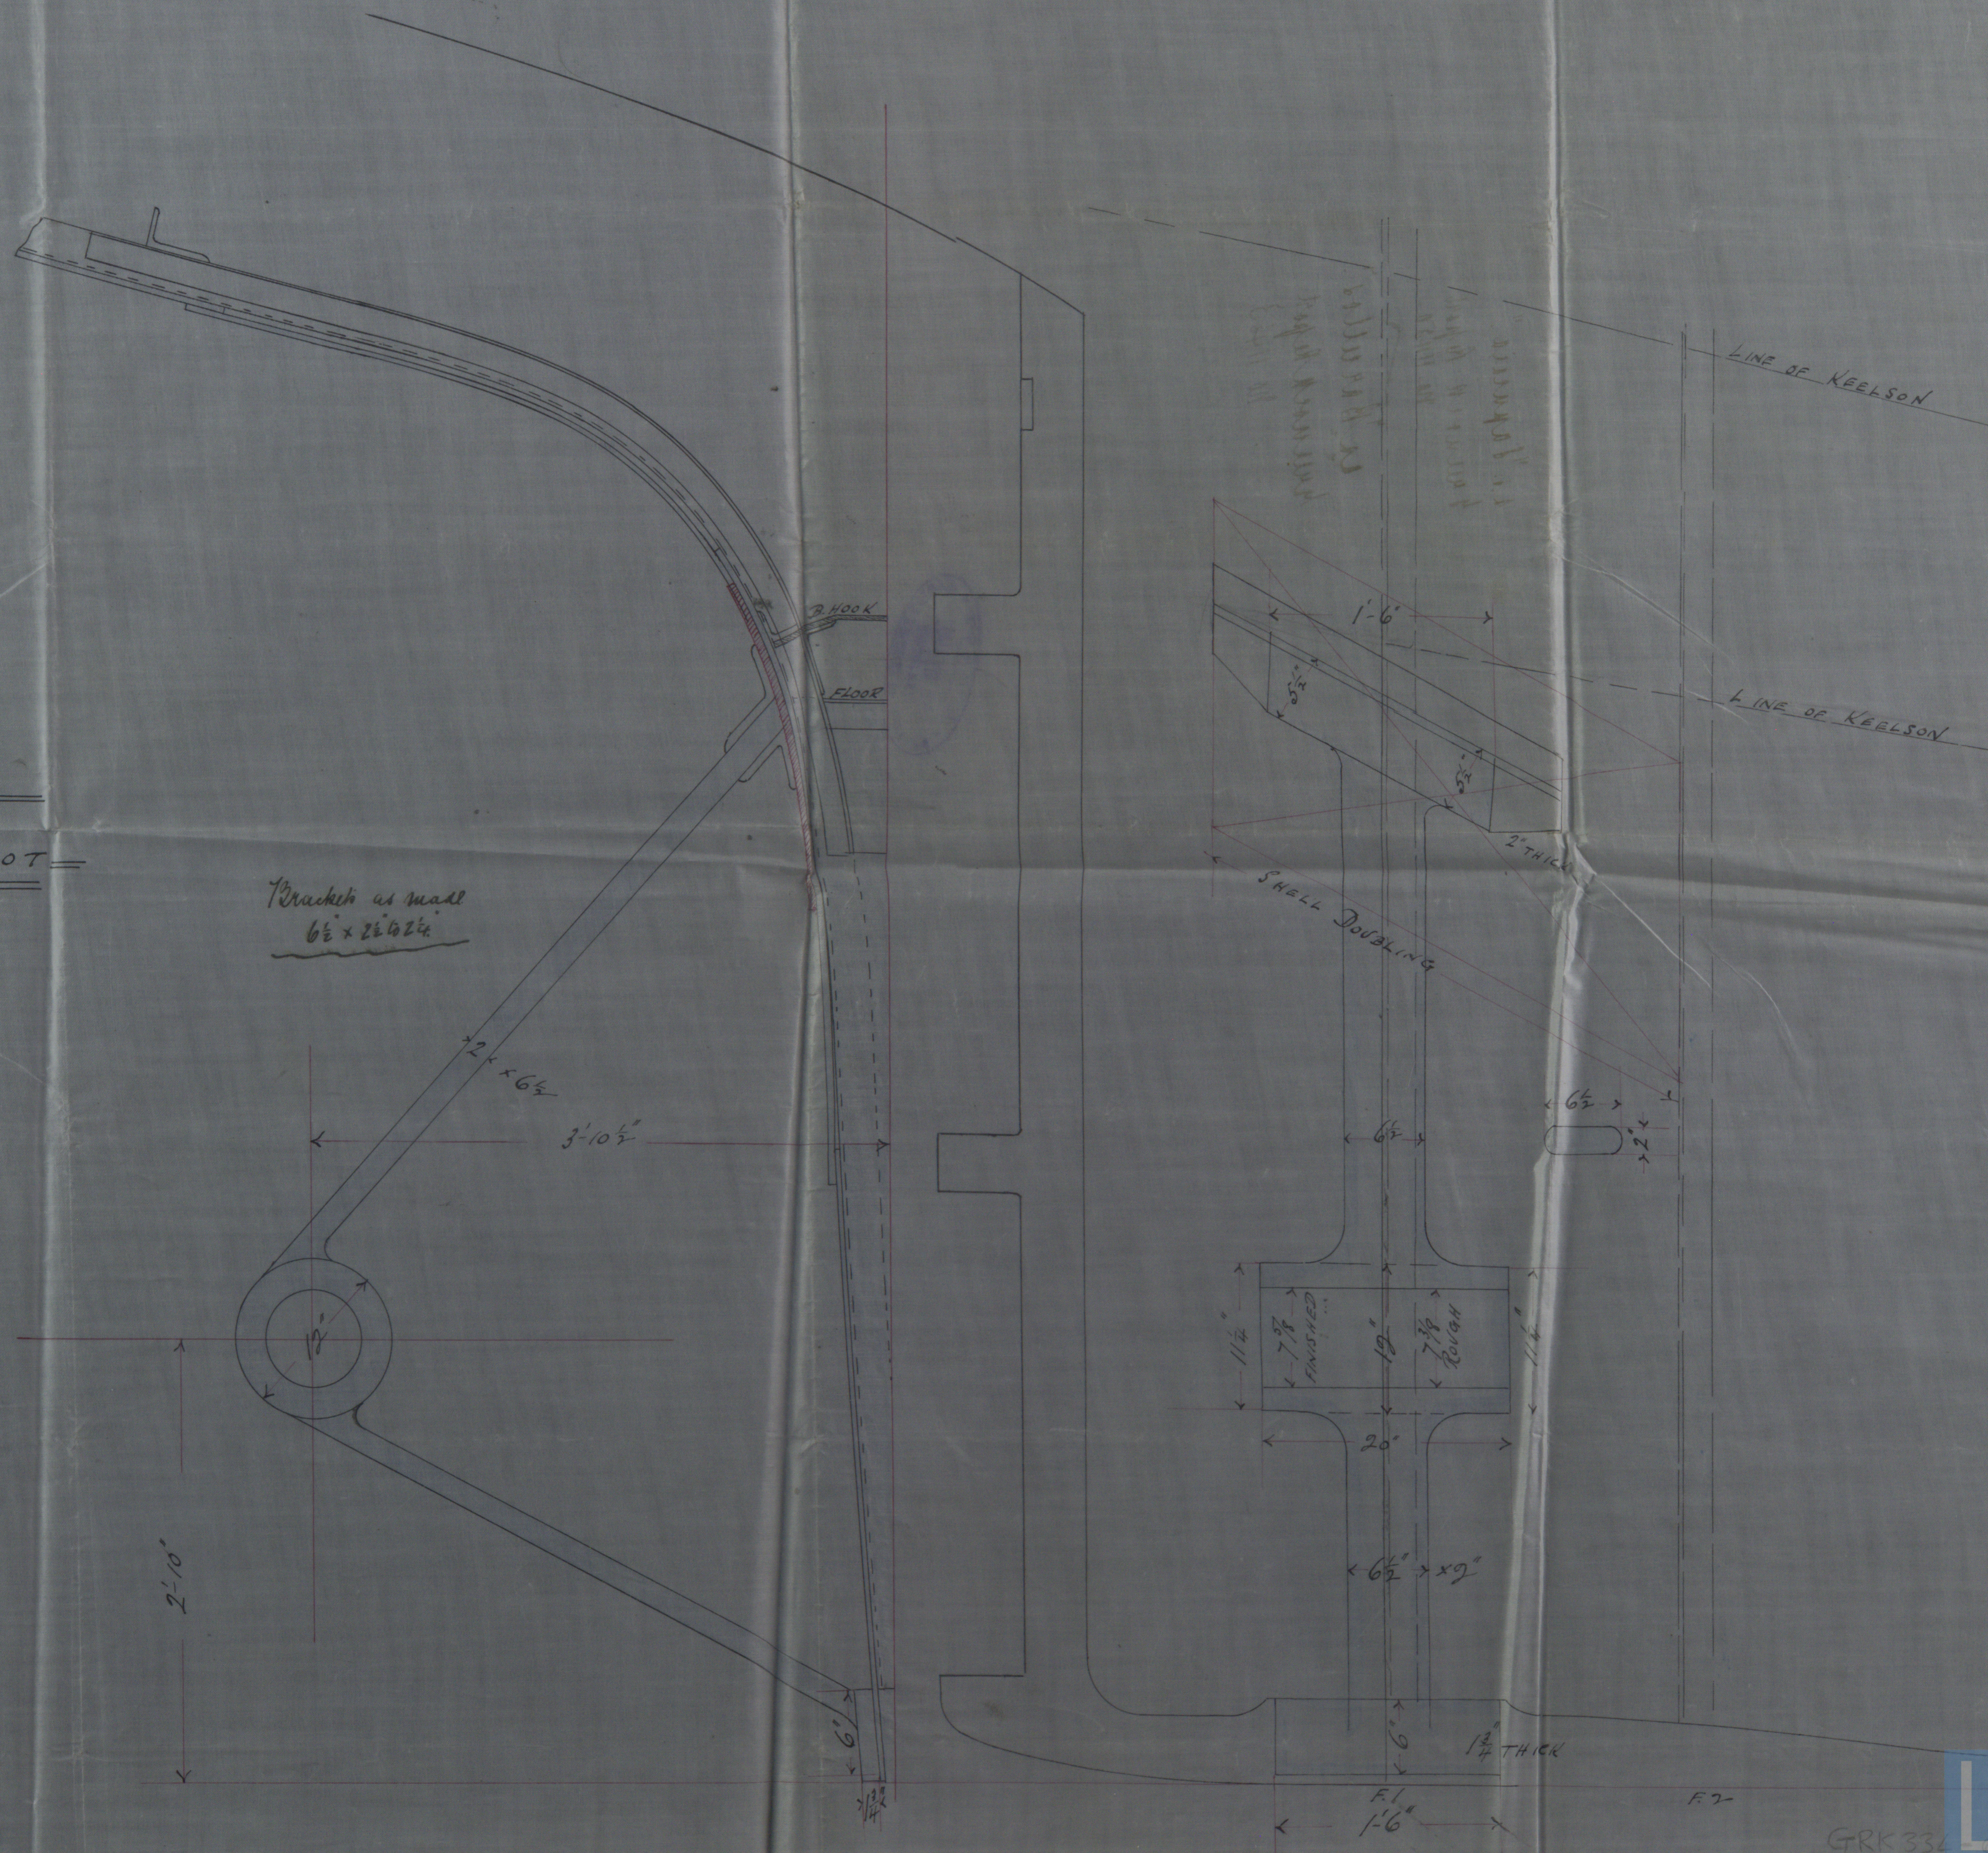

GRK334



Lloyd's Register
Foundation