

Received at Glasgow office, 21 Dec^r 1897

Lloyd's Register of British and Foreign Shipping.

(Report on Vessel No. 12114 Port Glasgow)

S.S. "Denewell"

No. 6010 SHIP FORGINGS OR CASTINGS.

The words FORGINGS or CASTINGS, IRON or STEEL, should be struck out as may be required.

I have to report that the undermentioned Iron or Steel Forgings or Castings, manufactured by Messrs Matthew Reid & Coy of Kilmarnock for the Vessel No. 281, being built by Messrs Robt Duncan & Coy of Port Glasgow have been inspected by me as set forth below, and found to be, so far as can be seen,

Mark on Forgings.


Lloyd's
No. 6010
W.H.

William Hamilton

Glasgow 17/12/97

	STERN FRAME.	RUDDER FRAME.	STEM.
Material*	<u>Scrap iron</u>		
How made	<u>Forged</u>		
Dimensions	<u>9 1/2</u>		
Progress on Inspection	<u>Forging & smithing</u>		
Date when Inspected	<u>8/10/97 to 16/12/97</u>		

SKETCHES OF FRAMES SHOWING POSITION AND DESCRIPTION OF WELDS OF FORGINGS, OR PARTICULARS OF TESTS APPLIED TO CASTINGS.

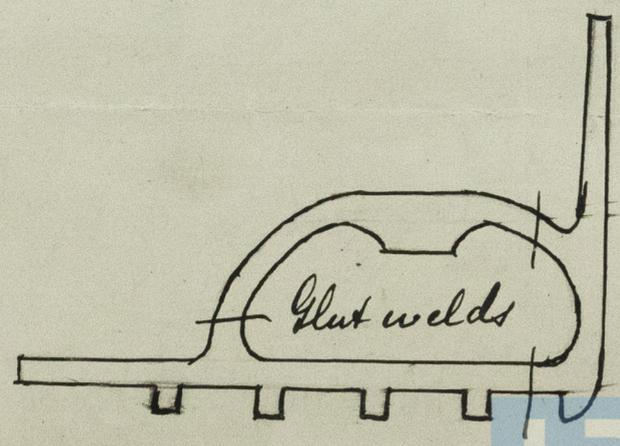

Fee (if any chargeable) £ : :

To be paid at

© 2019
Lloyd's Register
Foundation
J.M.
624342-0074

* If of Iron, state whether scrap or puddled Iron.