


28.4.97
6.5.97
27.10.97

NO. 10-H-12713

Midship Section of Steel Screw Tisk Carrier
To Class 100A at Lloyd's
Dimensions 130' x 22' 11" x 11' 0" mid to main dk
Scale $\frac{1}{2}$ in = 1 ft

Reg No 67
22nd April
1997

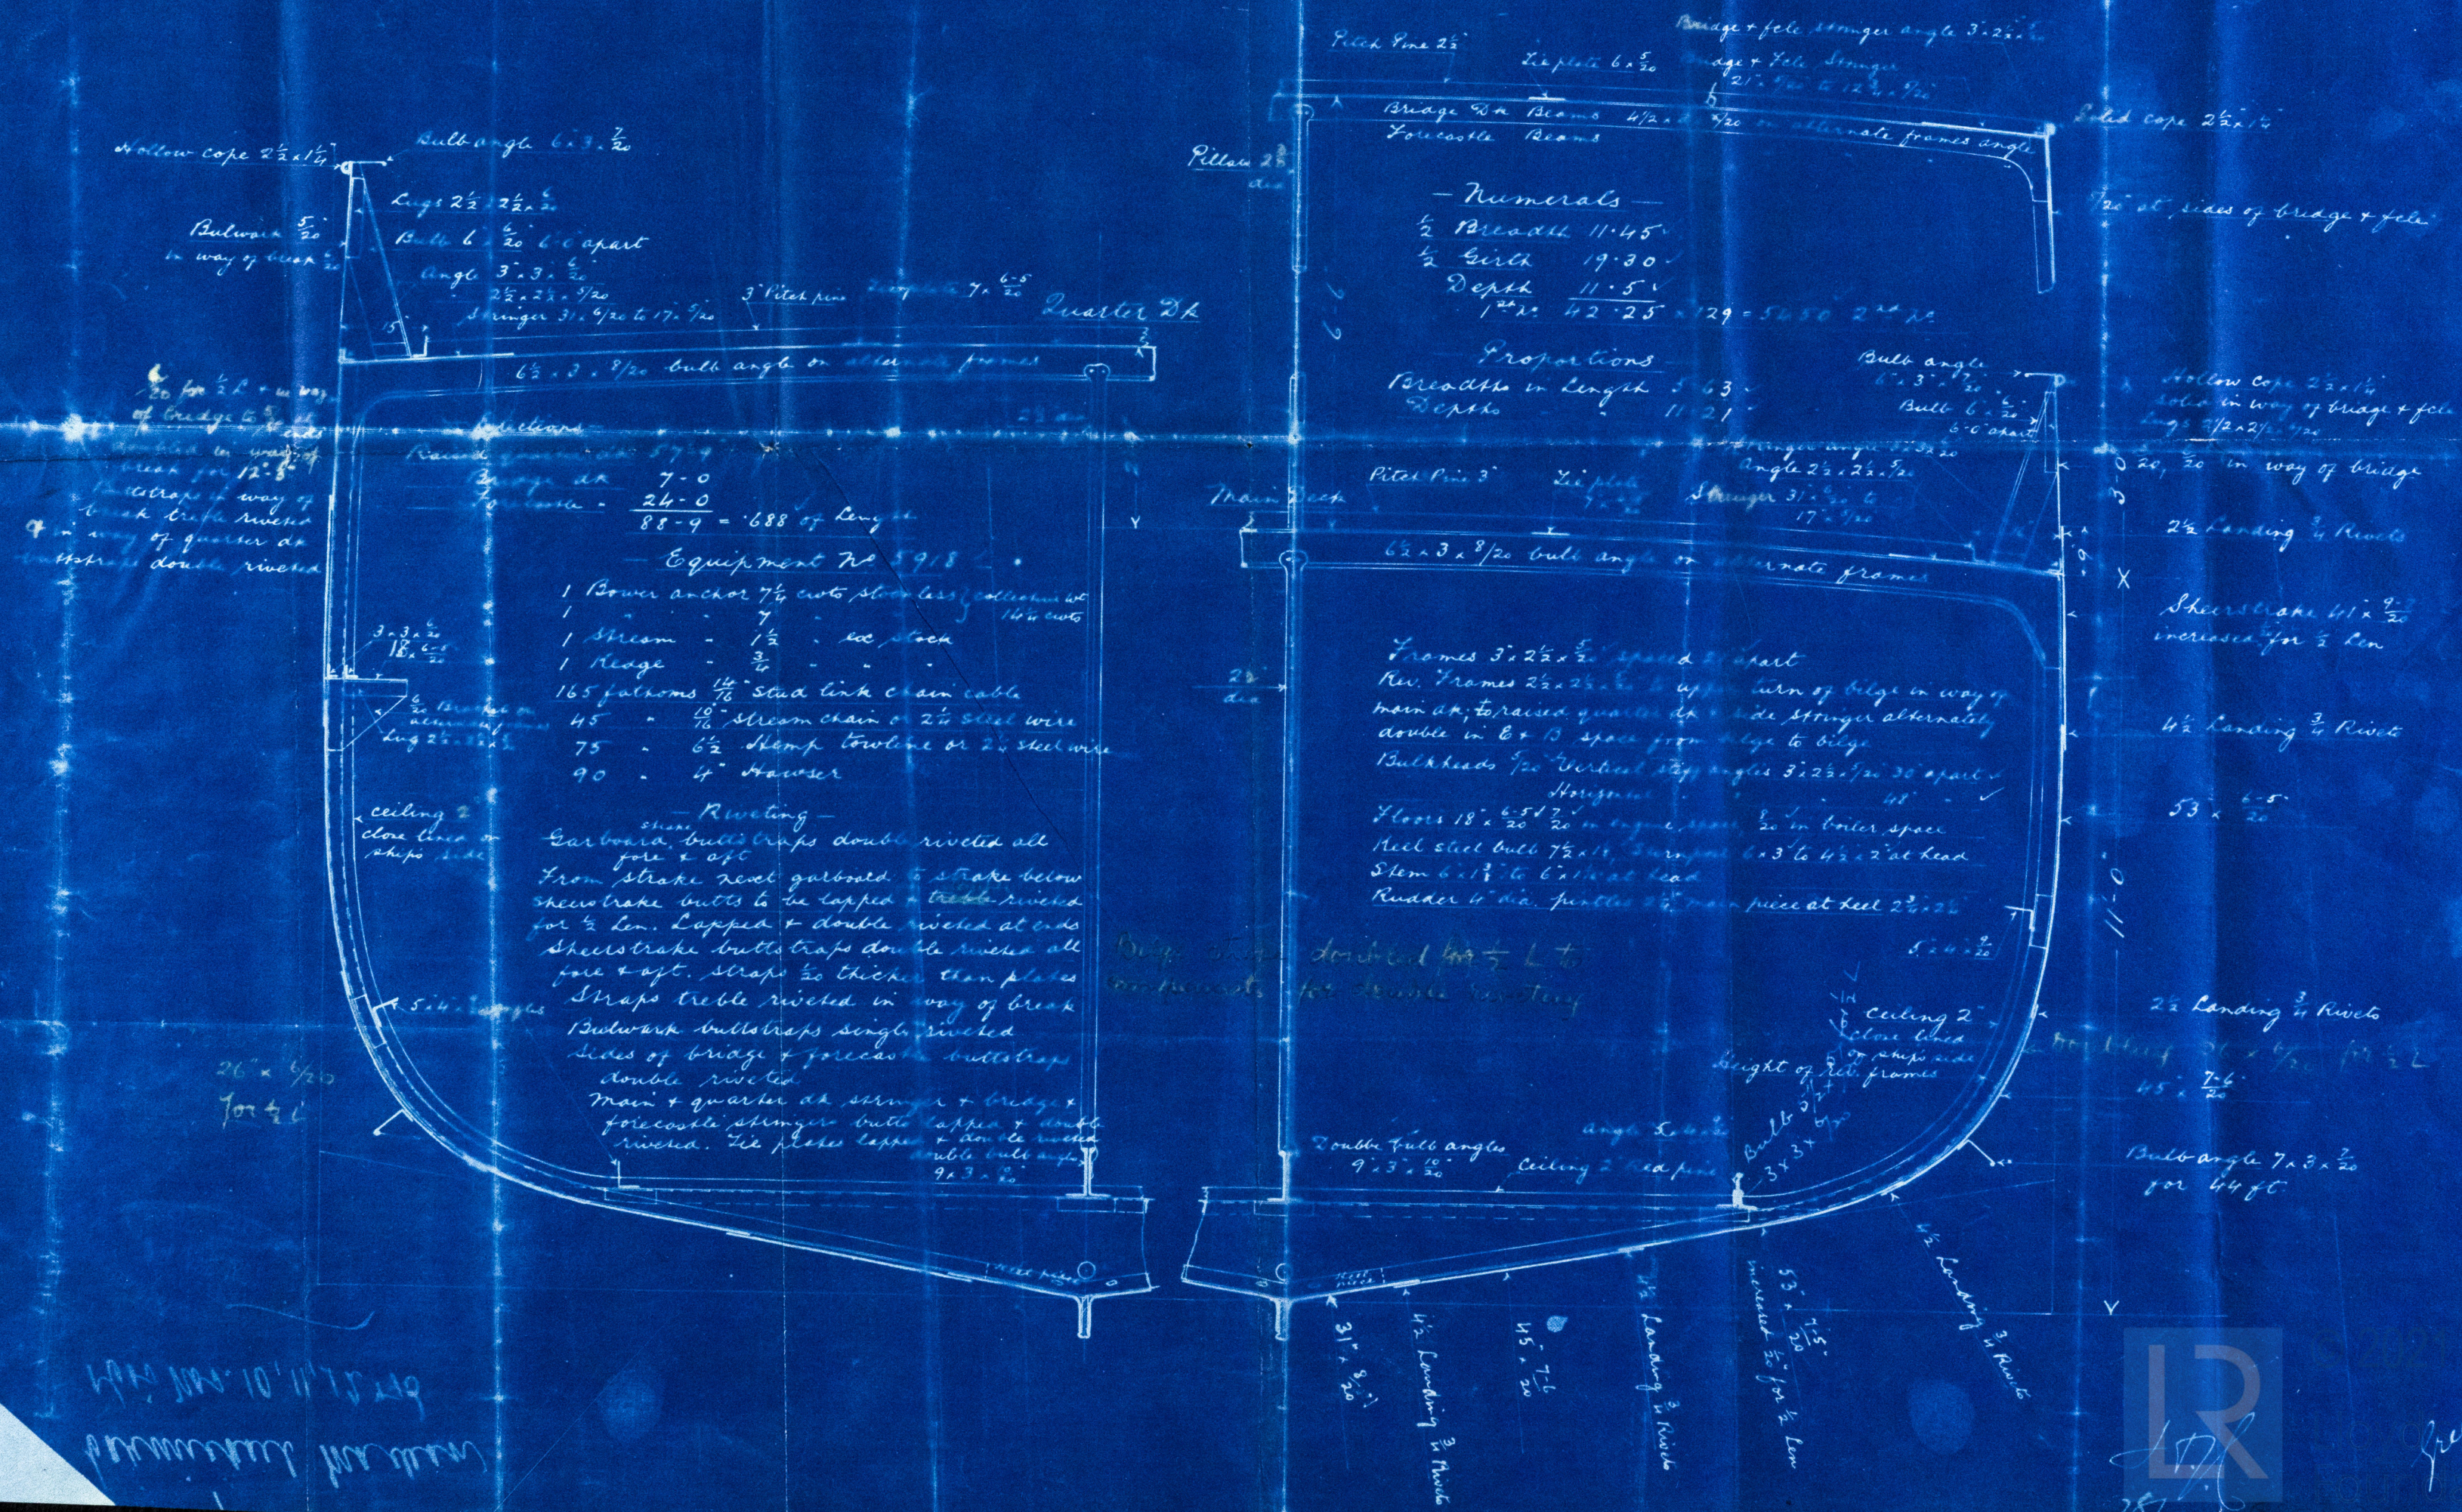

LR

Frederick
28/4/97

Carmichael Maclean & Co

S. S. No. 12

"Ajay"

Greenock 1st Entry Report
No. 12162

GRK 343-0001



© 2021

Lloyd's Register
Foundation

