

*Sp Ajax*

Received at

*Greenock* office, *4th Nov* 188*9*

Lloyd's Register of British and Foreign Shipping.

(Report on Vessel No. *12162* Port *Greenock*.)

No. *3905* SHIP FORGINGS OR CASTINGS.

I have to report that the undermentioned Iron or Steel Forgings or Castings, manufactured by *Messrs Emerson Walker & Thompson* of *Dunston* for the Vessel No. *12*, being built by *Messrs Carmichael & MacLone* of *Greenock* have been inspected by me as set forth below, and found to be, so far as can be seen, *sound*

The words FORGINGS or CASTINGS, IRON or STEEL, should be struck out as may be required.


Mark on Forgings.

Lloyd's  
No. *67713*  
*JB*

*John B Craig*  
*Newcastle*


	STERN FRAME.	RUDDER FRAME.	STEM.
Material*	<i>Scrap</i>	<i>Scrap</i>	/
How made	<i>Forged</i>	<i>Forged</i>	
Dimensions	<i>6-3</i>	<i>4-2 1/2</i>	
Progress on Inspection	<i>Forged &amp; Smithed</i>	<i>Forged &amp; Smithed</i>	
Date when Inspected	<i>June 17 to July 13/87</i>	<i>September 7 to 30/87</i>	

SKETCHES OF FRAMES SHOWING POSITION AND DESCRIPTION OF WELDS OF FORGINGS, OR PARTICULARS OF TESTS APPLIED TO CASTINGS.

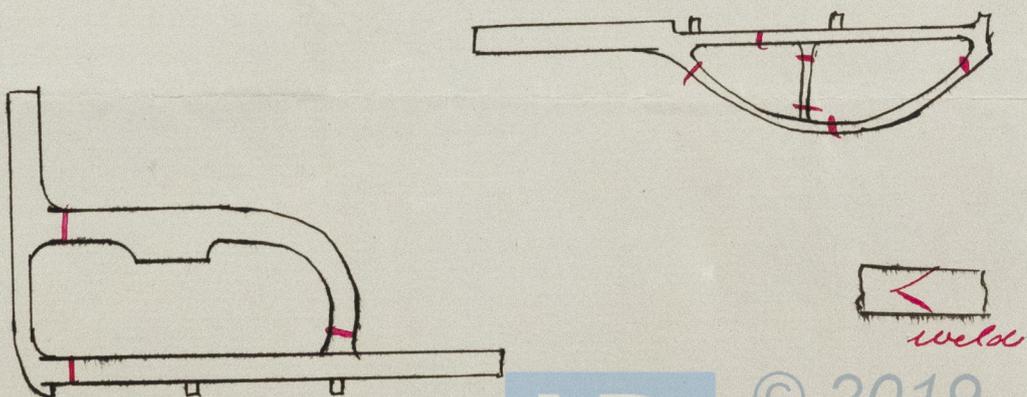

Fee (if any chargeable) £ : :

To be paid at

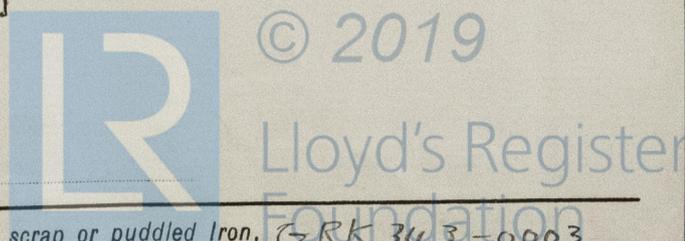

\* If of Iron, state whether scrap or puddled Iron. GRK 343-0003