

St Velse

Received at

Greenock office, *4th Nov. 1889*

Lloyd's Register of British and Foreign Shipping.

(Report on Vessel No. *12163* Port *Greenock*.)

No. *3906*

SHIP FORGINGS OR CASTINGS.

The words FORGINGS or CASTINGS, IRON or STEEL, should be struck out as may be required.

I have to report that the undermentioned Iron or Steel Forgings or Castings, manufactured by *Messrs Emerson Walker & Thompson* of *Dunston* for the Vessel No. *13*, being built by *Messrs Barnichael MacLaine & Co* of *Greenock* have been inspected by me as set forth below, and found to be, so far as can be seen, *Sound*


Mark on Forgings.

Lloyd's
No. *6772B*
JB

John B Craig
Newcastle

	STERN FRAME.	RUDDER FRAME.	STEM.
Material*	<i>Scrap</i>	<i>Scrap</i>	/
How made	<i>Forged</i>	<i>Forged</i>	
Dimensions	<i>6-3</i>	<i>4-2 1/2</i>	
Progress on Inspection	<i>Forged & Smithed</i>	<i>Forged & Smithed</i>	
Date when Inspected	<i>July 3 to 22/27</i>	<i>September 7 to 30/27</i>	

SKETCHES OF FRAMES SHOWING POSITION AND DESCRIPTION OF WELDS OF FORGINGS, OR PARTICULARS OF TESTS APPLIED TO CASTINGS.

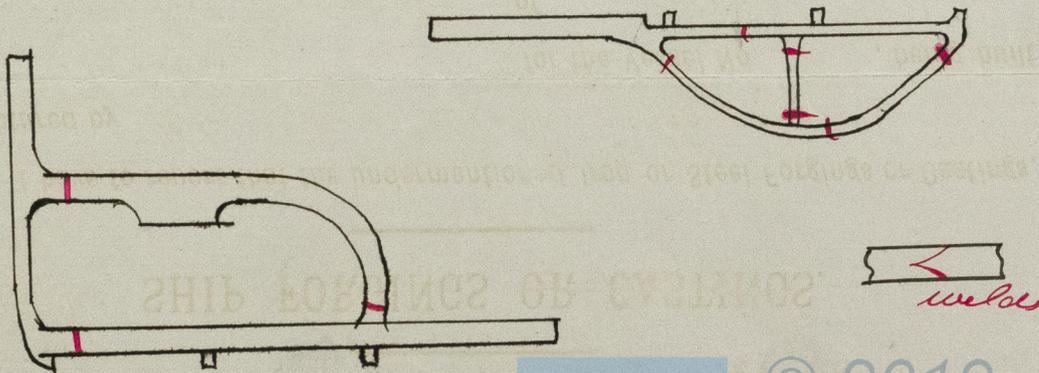

Fee (if any chargeable) £ : :
To be paid at

