

S.S. "Alon"

Received at West Hartlepool Office, Nov 6 1889

# Lloyd's Register of British and Foreign Shipping.

Hpool

(Report on Vessel No. 4818 Port West Hartlepool)

No. 1349A

## SHIP FORGINGS OR CASTINGS.

The words FORGINGS or CASTINGS, IRON or STEEL, should be struck out as may be required.

I have to report that the undermentioned Iron or Steel Forgings or Castings, manufactured by The Darlington Forge Co of Darlington for the Vessel No. 242, being built by Messrs Roper & Son of Stockton have been inspected by me as set forth below, and found to be, so far as can be seen, sound.

Mark on Forgings.


Lloyd's  
No. 1349A  
No. 6.

Wm Cameron

Sunderland 5/11/89

	STERN FRAME.	RUDDER FRAME.	STEM.
Material*	<u>Superior</u>	<u>Superior</u>	
How made	<u>Forged</u>	<u>Forged</u>	
Dimensions	<u>9' 5 1/2"</u>	<u>7' 3 1/2"</u>	
Progress on Inspection	<u>Forged &amp; Smithed</u>	<u>Smithed</u>	<u>not seen</u>
Dates when Inspected	<u>June 8-26 July 9-15-19-25-29-31</u> <u>Aug 12-16-23/89</u>	<u>Oct 1-4-8-11-17-20/89</u>	

SKETCHES OF FRAMES SHEWING POSITION AND DESCRIPTION OF WELDS OF FORGINGS, OR PARTICULARS OF TESTS APPLIED TO CASTINGS.

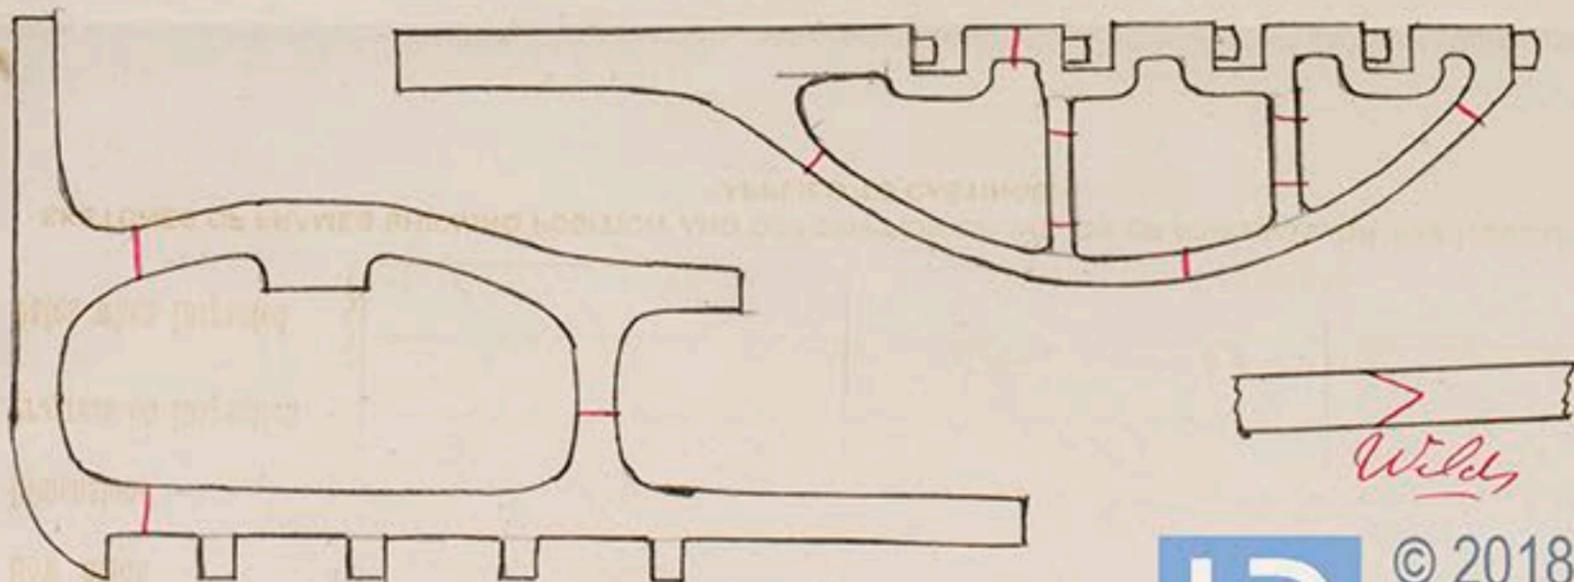

© 2018

Lloyd's Register Foundation

\* If of Iron, state whether scrap or puddled Iron.

1349