

J. S. Bernholzer

Received at **WEST HARTLEPOOL** Office.

9. 12 1895.

Lloyd's Register of British and Foreign Shipping.

West Hartlepool (Report on Vessel No. 9854 Port **WEST HARTLEPOOL.**)

No. 3075 a. SHIP FORGINGS OR CASTINGS.

The words FORGINGS or CASTINGS, IRON or STEEL, should be struck out as may be required.

I have to report that the undermentioned Iron or Steel Forgings or Castings, manufactured by *Messrs Gray & Co.* of *West Hartlepool* for the Vessel No. *509*, being built by *Messrs Gray & Co.* of *West Hartlepool* have been inspected by me as set forth below, and found to be, so far as can be seen, *sound.*

Mark on Forgings.

Lloyd's
No. 3075 a
No. 6.

Rough Cameron

Sunderland


4 - 12 - 95.

	STERN FRAME.	RUDDER FRAME.	STEM.
Material*	<i>Scrap iron</i>	<i>Scrap iron</i>	<i>Scrap iron</i>
How made	<i>Forged</i>	<i>Forged</i>	<i>Forged</i>
Dimensions	<i>10" x 6"</i>	<i>8" x 4"</i>	<i>10" x 2 3/4"</i>
Progress on Inspection	<i>Forged & smithed</i>	<i>Forged & smithed</i>	<i>Forged</i>
Date when Inspected	<i>July 19th to Sept 2/95</i>	<i>Sept 13th to Nov 23/95</i>	<i>Aug 27/95</i>

SKETCHES OF FRAMES SHOWING POSITION AND DESCRIPTION OF WELDS OF FORGINGS, OR PARTICULARS OF TESTS APPLIED TO CASTINGS.



Welds

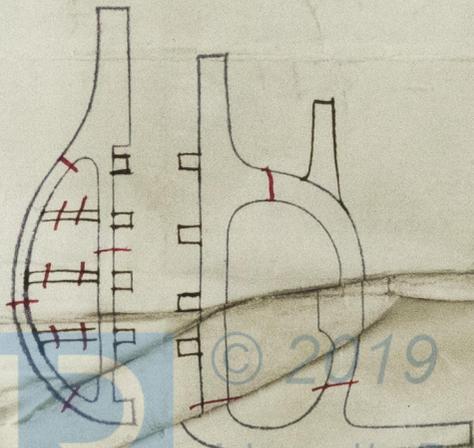

Fee (if any chargeable) £ : :

To be paid at

* If of Iron, state whether scrap or puddled Iron.