


Handwritten notes in the top right corner, including '1/2' and '1/4'.

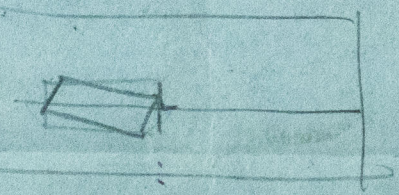

© 2020

Lloyd's Register
Foundation

Hul 396

Revised Sketch of head of Stern-post.


Scale $\frac{1}{2}$ " = 1 foot.

S.S. "Mariano"


Naval Report No. 5425



No 26h
Dr. H. J. Hull
6/14/83.

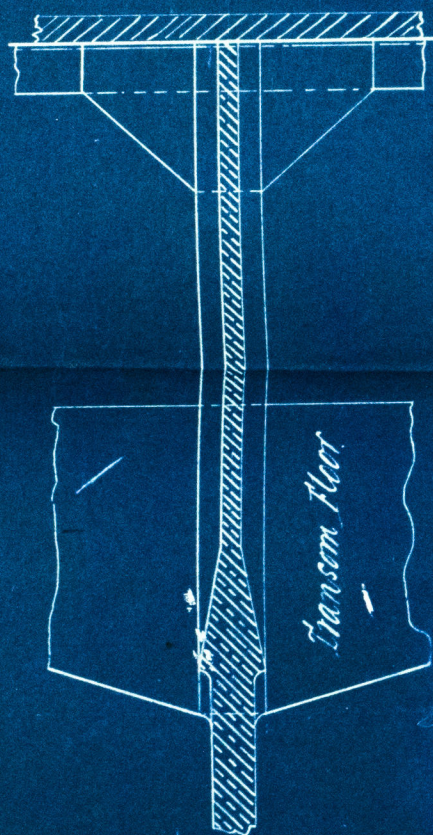

Section at after side
of Stern-post.

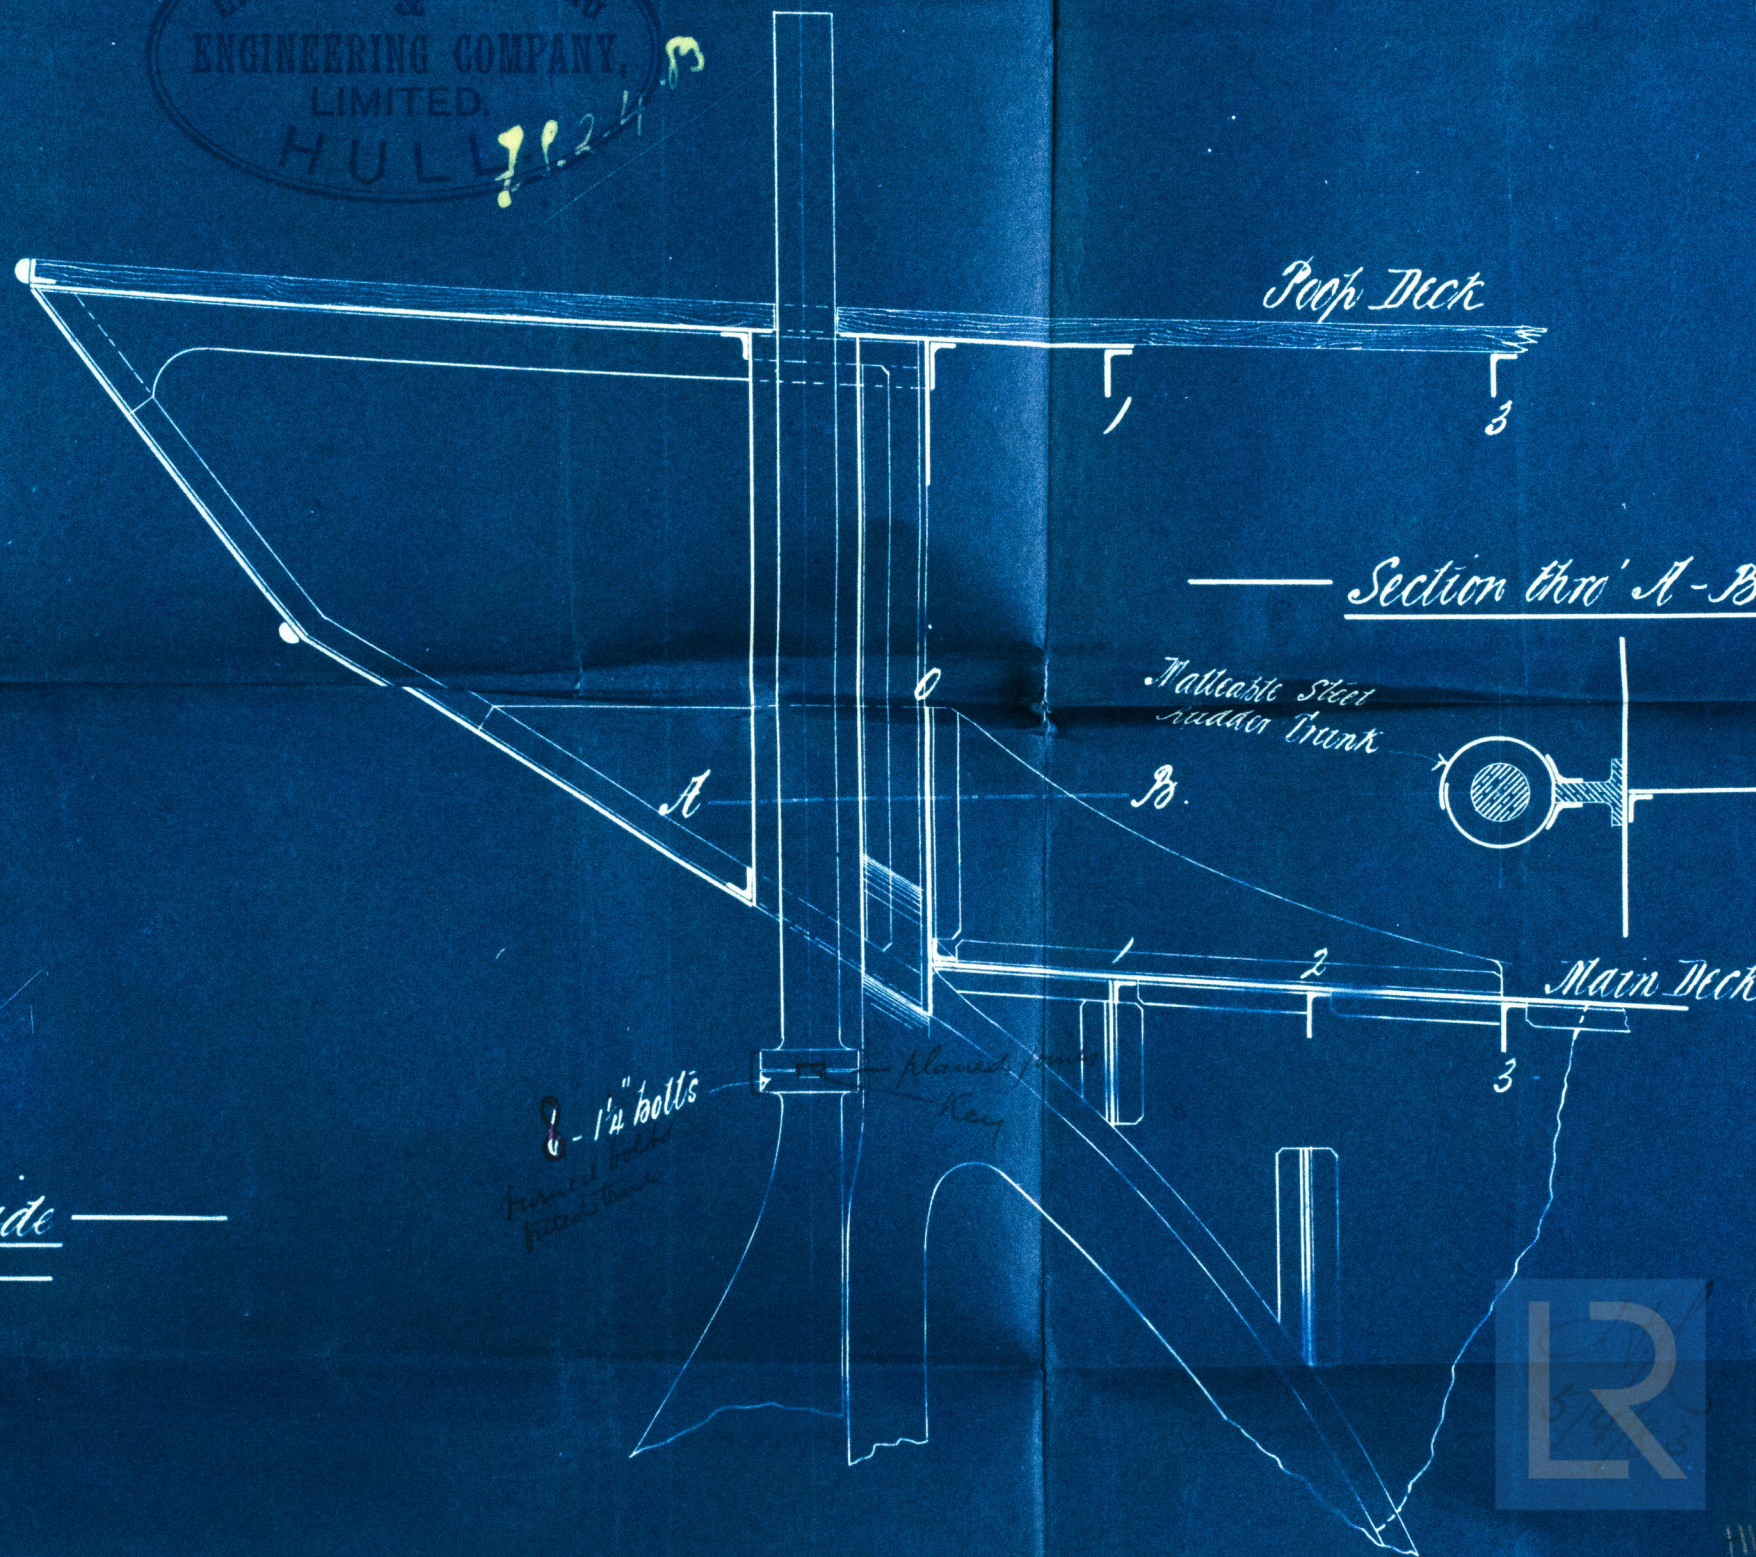

Section thro' A-B.




See also 314
7/1/83

