

Dimensions per Route

Midship Section.

S.S. $273.5 \times 34 \times 21.75$


Scale $\frac{1}{2}$ inch = 1 foot.

Numbers 74.25 & 20308.

Class 100 A. Street



S. A. Hull
1/2/83.
12/2/83.
6/3/83.
26/4/83
11/9/83.

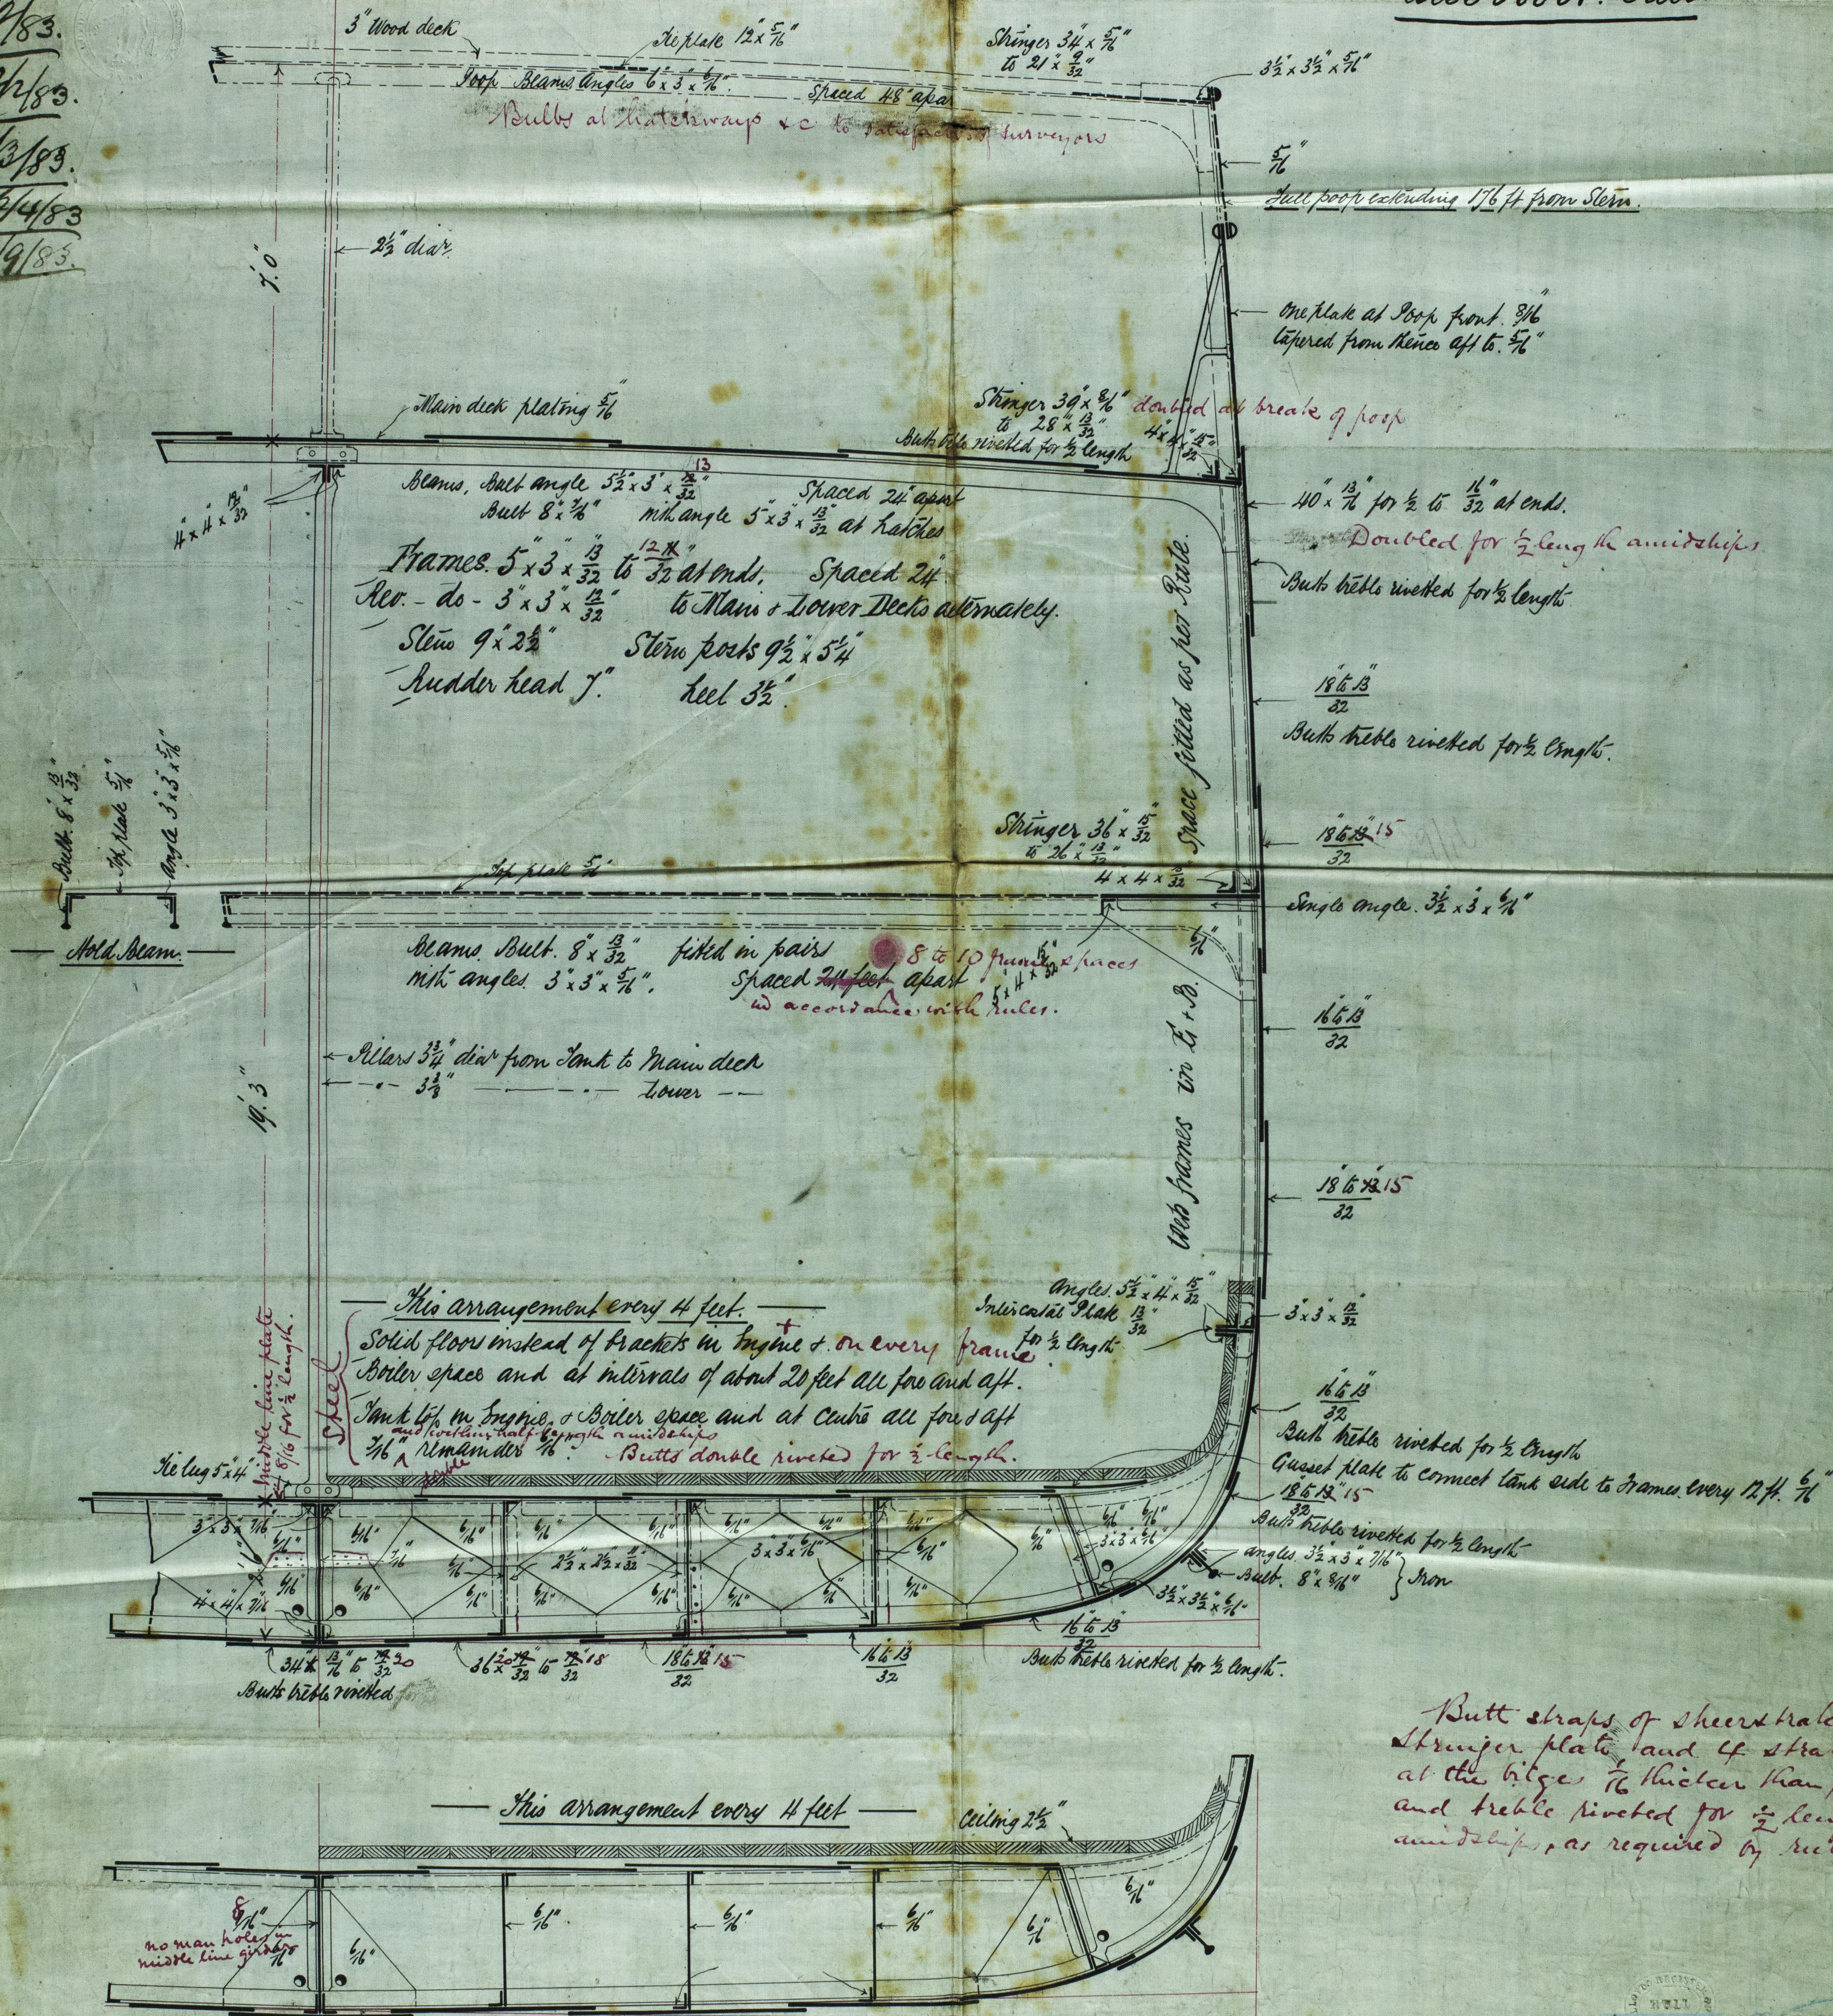

Butt straps of sheer trunks
stronger plate and 4 straps
at the bitge $\frac{1}{2}$ thicker than plates
and treble riveted for $\frac{1}{2}$ length
amidships, as required by rules.

J. A. C. V. M.
 1/2/83



© 2020
Lloyd's Register
Foundation

HVL396-0213