

S. S. "Elsy" Hull Report No: 5465.

Non

Dimensions
Length 80 ft 0 in
Breadth 19 ft 3 in
Depth moulded 9 ft 0 in
Half Girth 17 ft 6 in

Midship Section of 80^{ft} Screw Cargo Boat Scale 1/2 to a Foot


To Class 90 R Lloyds

Members for Frames Keel etc = 35.9
Do " Plating etc = 2876.0

Dr: W. Hull

2/3/83.

at Raised Quarter Deck

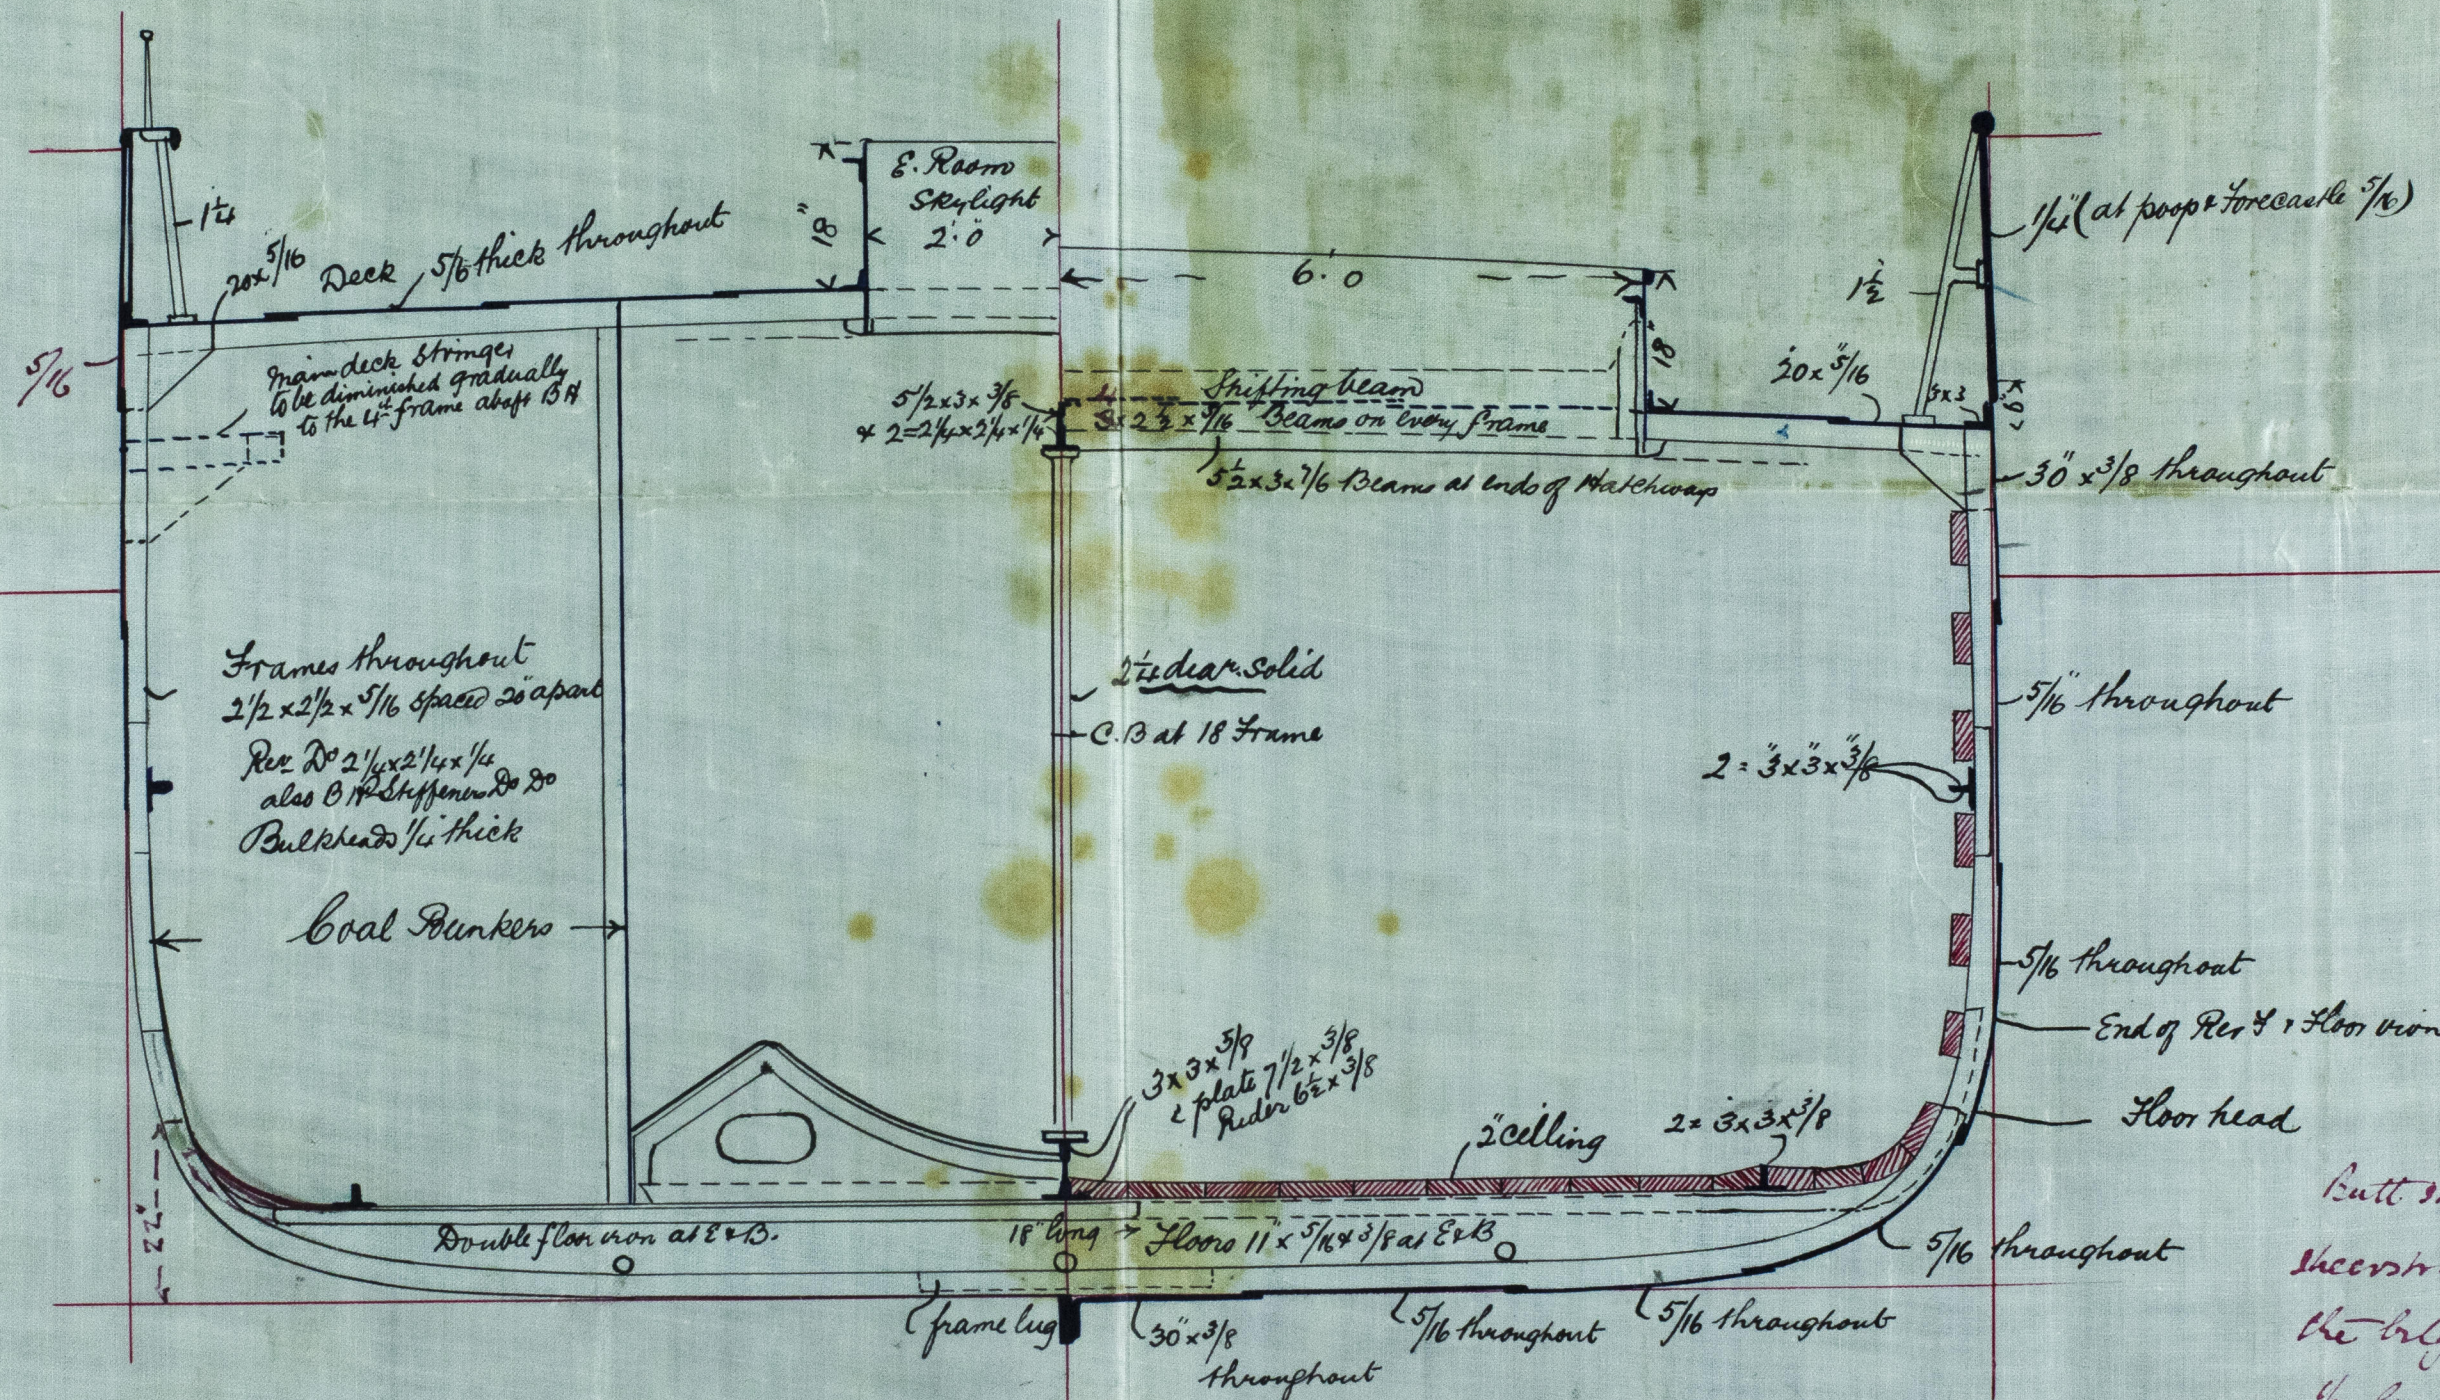

Keel Bar 6"x1 1/8"
Stem " 5 1/2"x1 1/8"
Stern Frame 5 1/2"x2 1/4"
Rudder head 3' deep
Keel & plates 2'

Butt straps of stringer plate
sheerstrake & one strake at
the bridge to be 1/16 thicker for
1/2 length & double riveted

J.H.
2/3/83