


11/4/76

S. S. Douglas  
Greenock Report  
No. 4062

Rec 11/4/76  
H

Longitudinal Section of Screw Steamer No 19  
Scale  $\frac{1}{4}$  Inch = 1 Foot

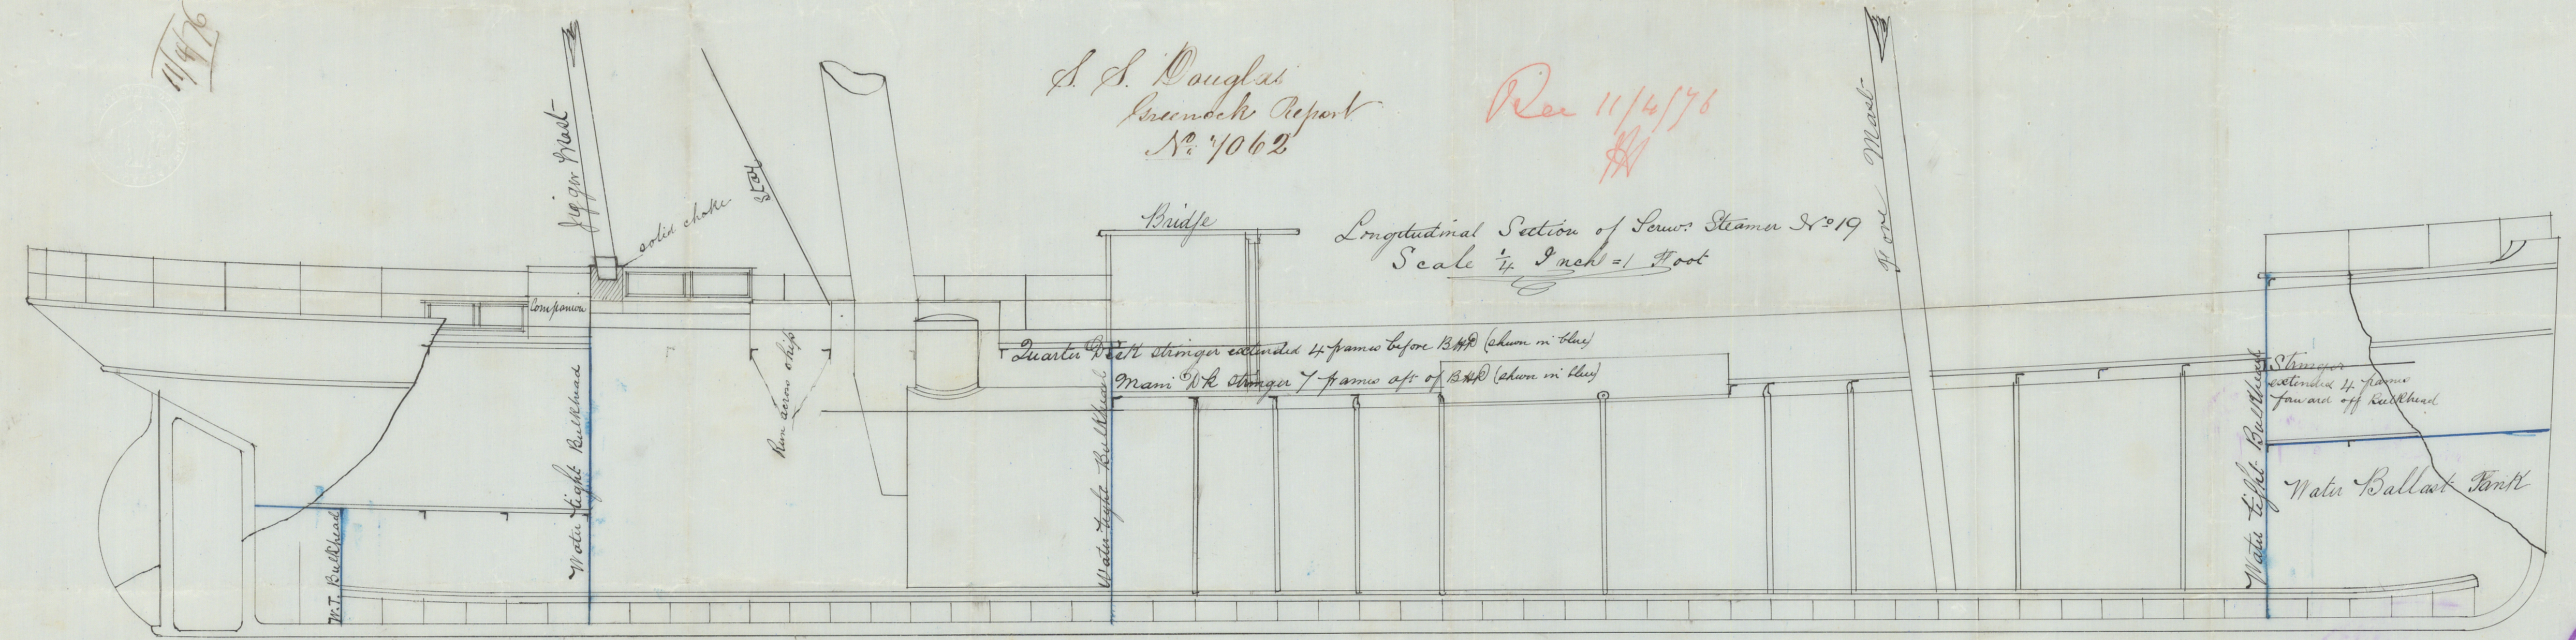

5th April 1876

IRONSTEEL 0081




© 2021  
Lloyd's Register  
Foundation




11/4/76

S. S. Douglas  
Greenock Report  
No. 7062

Rec 11/4/76  
H

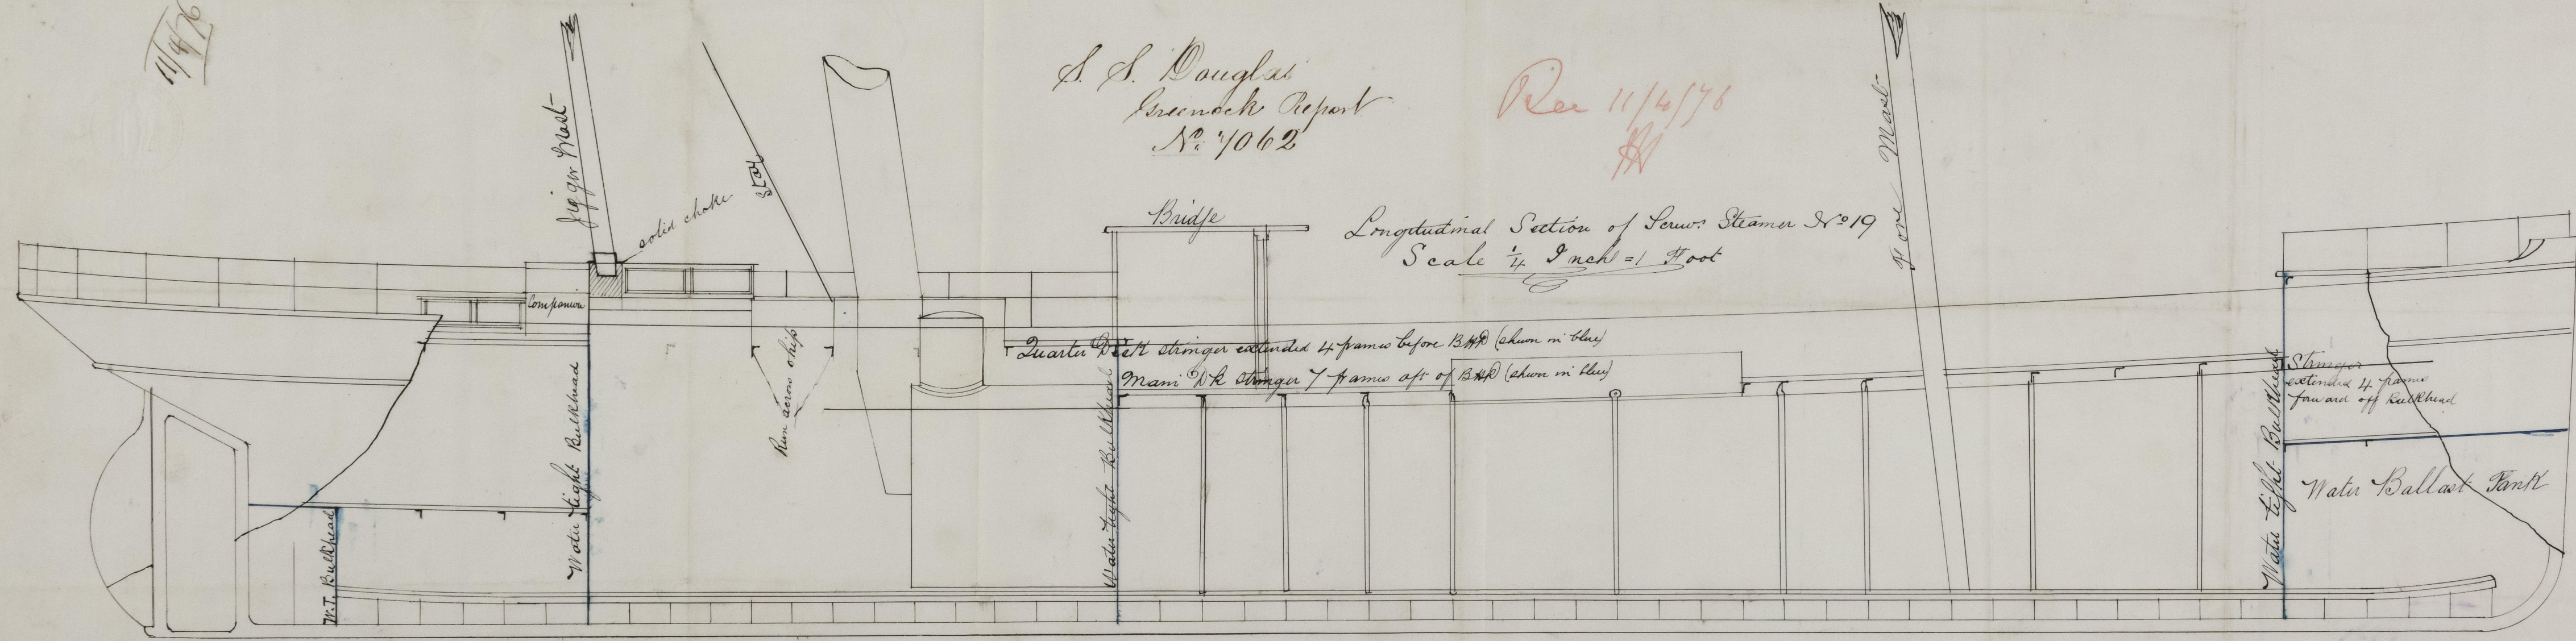

Longitudinal Section of Stern Steamer No. 19  
Scale  $\frac{1}{4}$  Inch = 1 Foot

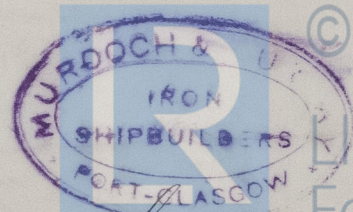

© 2021

Lloyd's Register  
Foundation

5th April 1876

IRONSHIP 0081