

# LOCH ETIVE & LOCH SUNART

Midship Section of Nos. 134 + 135 Sailing Ships

Glasgow Report

No. 4573


Scale  $\frac{1}{2}$  inch = one foot

To class 100 A.1. at Lloyds

$\frac{1}{2}$  Breadth 17.75  
 $\frac{1}{2}$  Girth 36.15  
Depth 23.7

$77.6 + 215.7 = 16738$  Scantling No  
17853 Equipment No

Proportions  
over 6 + under 6 1/2 Breadths  
" 9 " 9 1/2 Depths

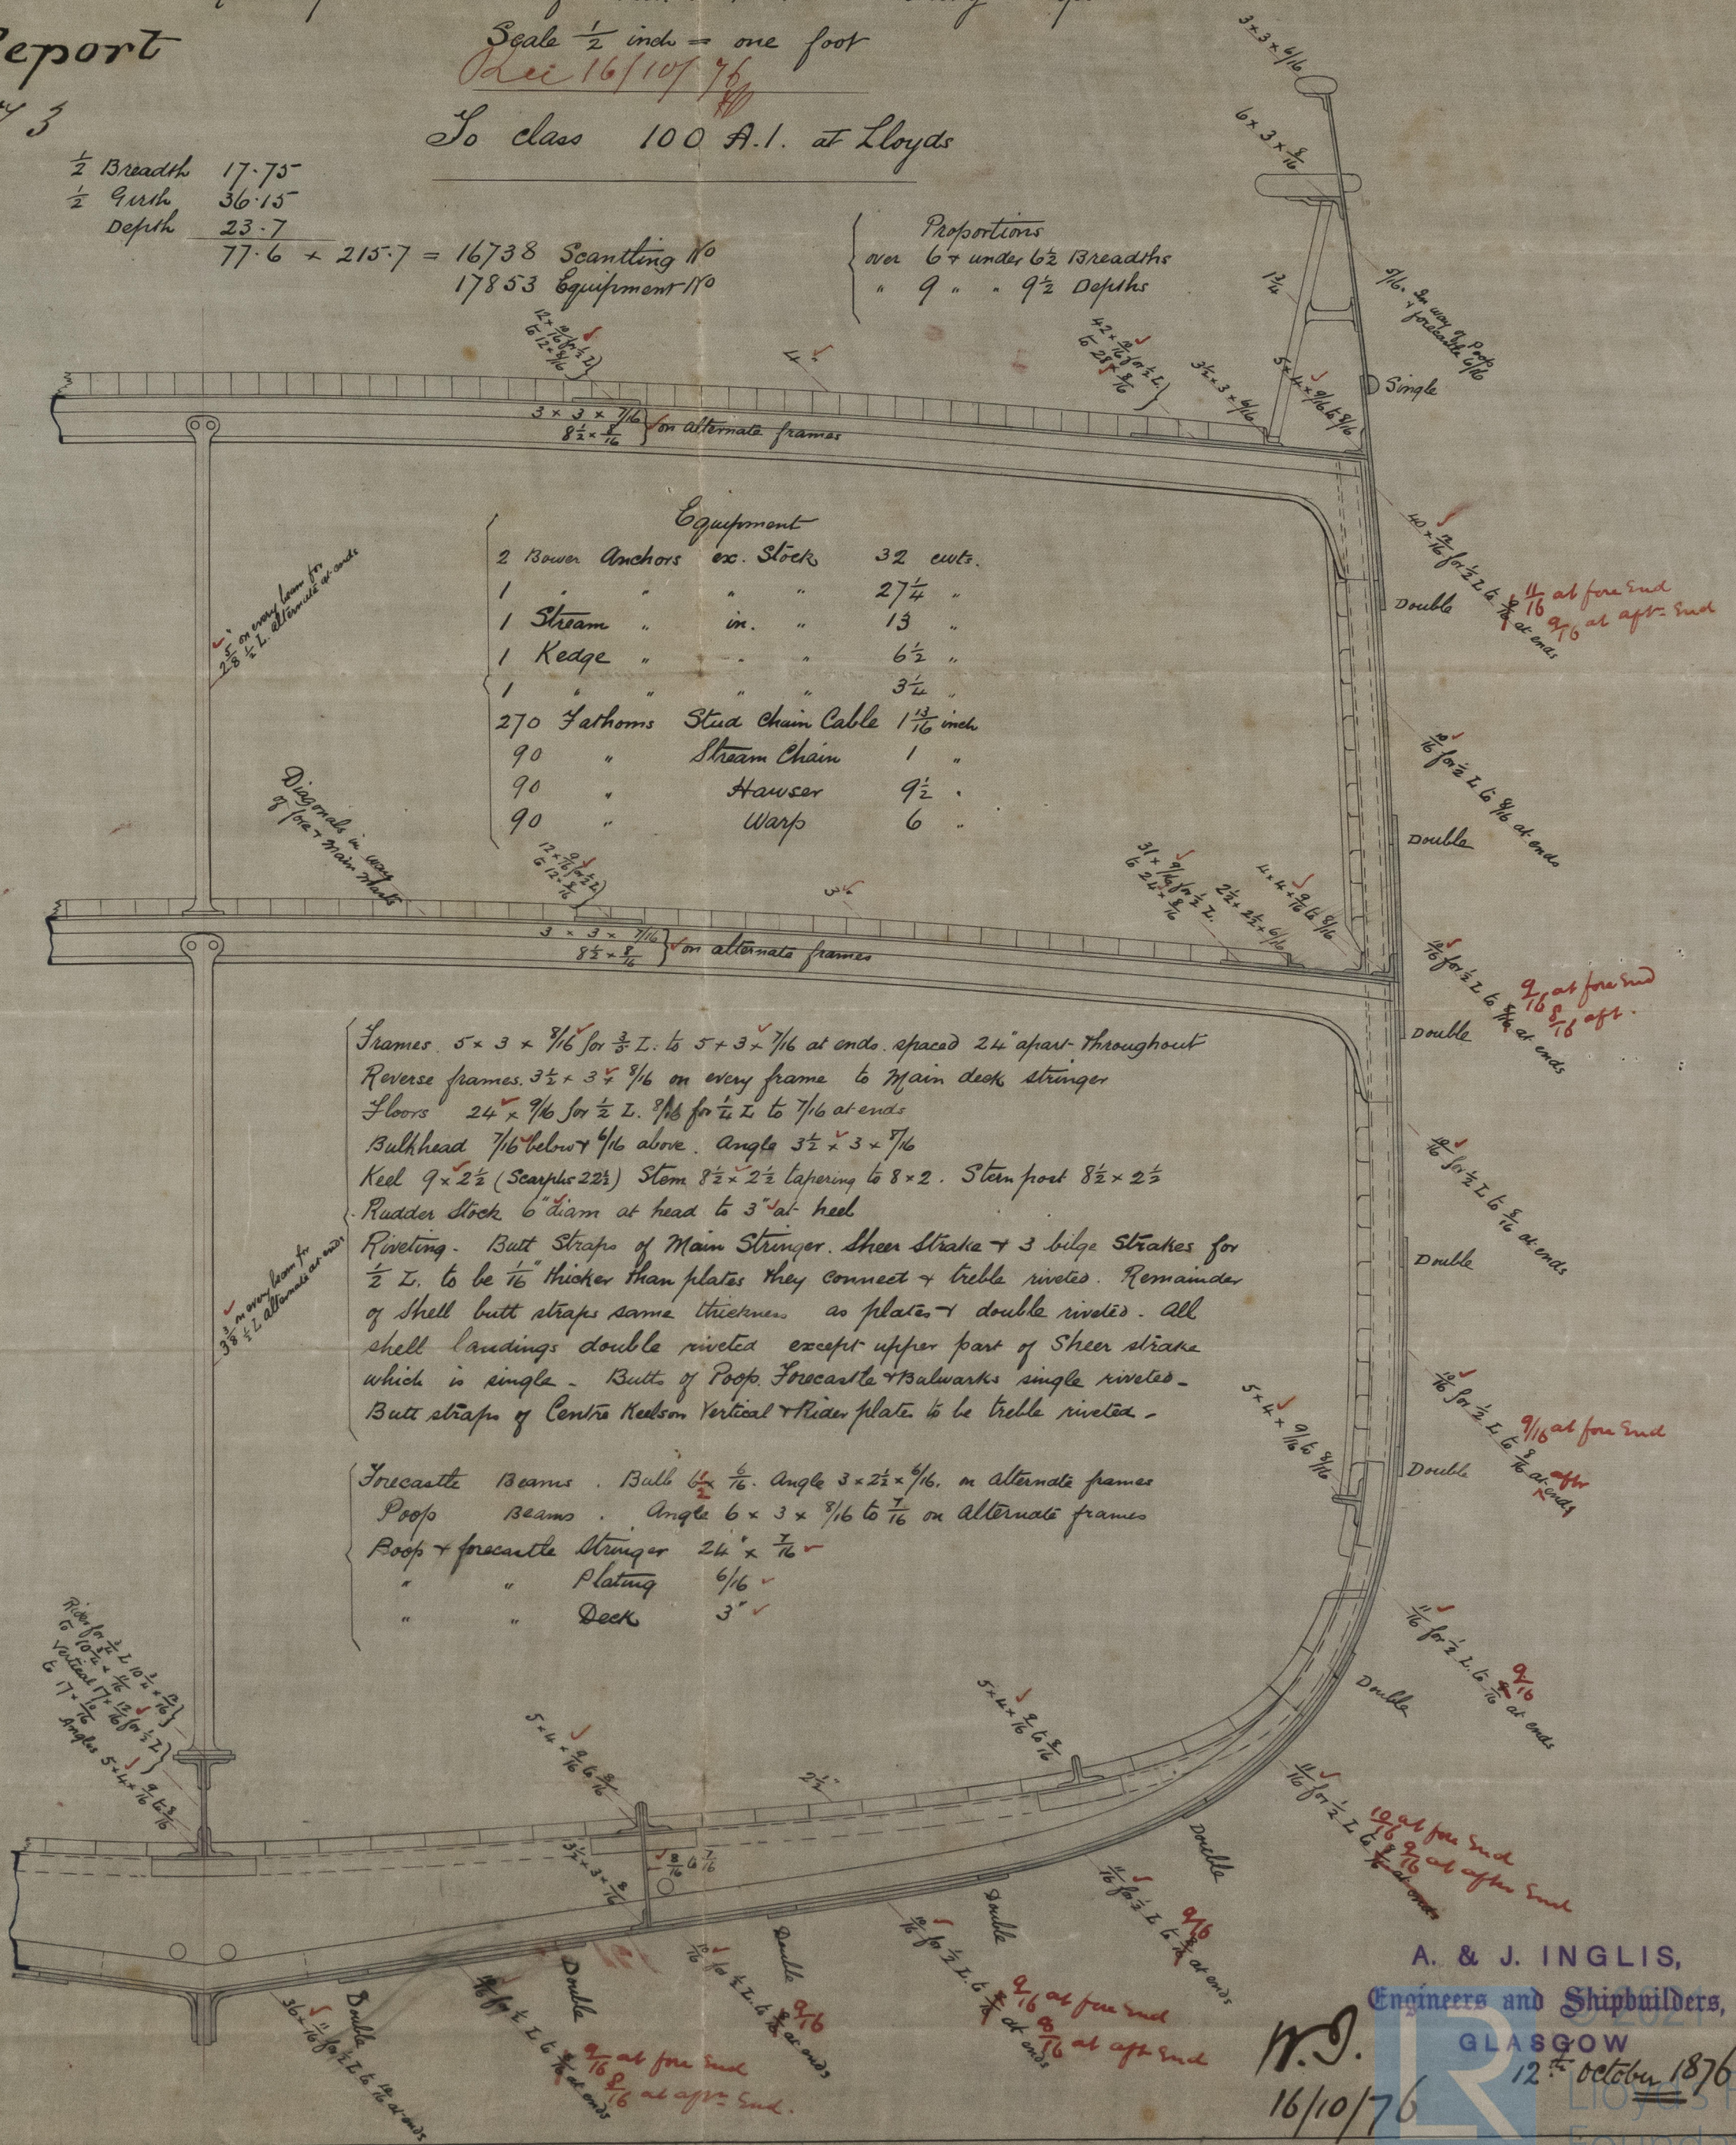

A. & J. INGLIS,  
Engineers and Shipbuilders,  
GLASGOW

W.D.  
16/10/76

12<sup>th</sup> October 1876

Lloyds Register  
Foundation

CONS 24-0165