


"FANNY" *Glasgow Report No 4634*
 Longitudinal Section of No 145. S. S.
 20 class 100 A.1.
 Scale $\frac{1}{4}$ " = one foot.

Rev 6/11/77
HA

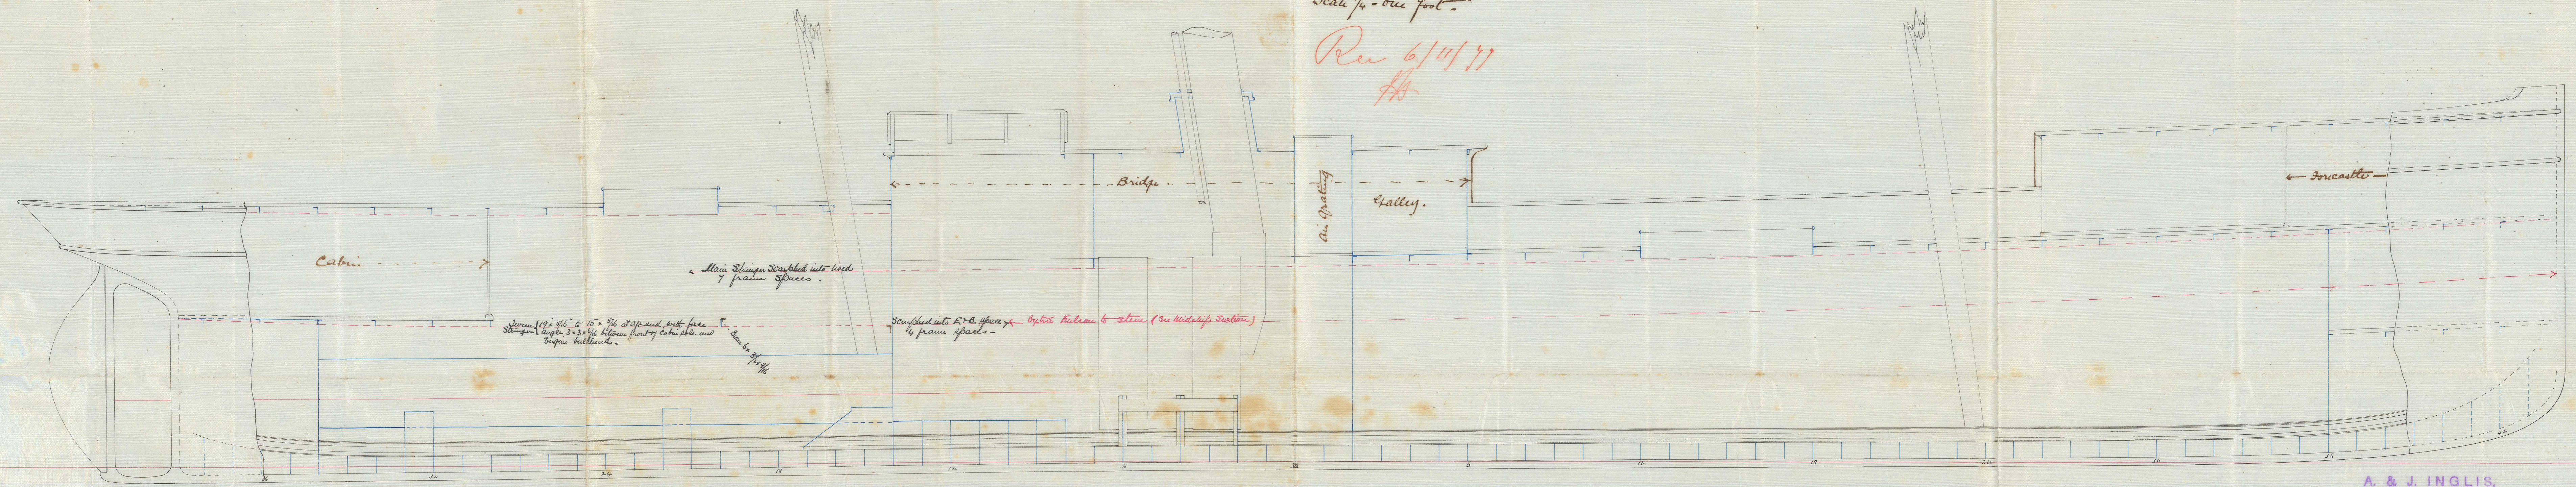

A. & J. INGLIS,
 Engineers and Shipbuilders,
 GLASGOW

J.H.
6/11/77

5th November 1877.