


"Compton". - Report No 13893.

Nº 105

ELEVATION & DECK-PLAN

SCALE  $\frac{1}{8}$ " = 1 FT


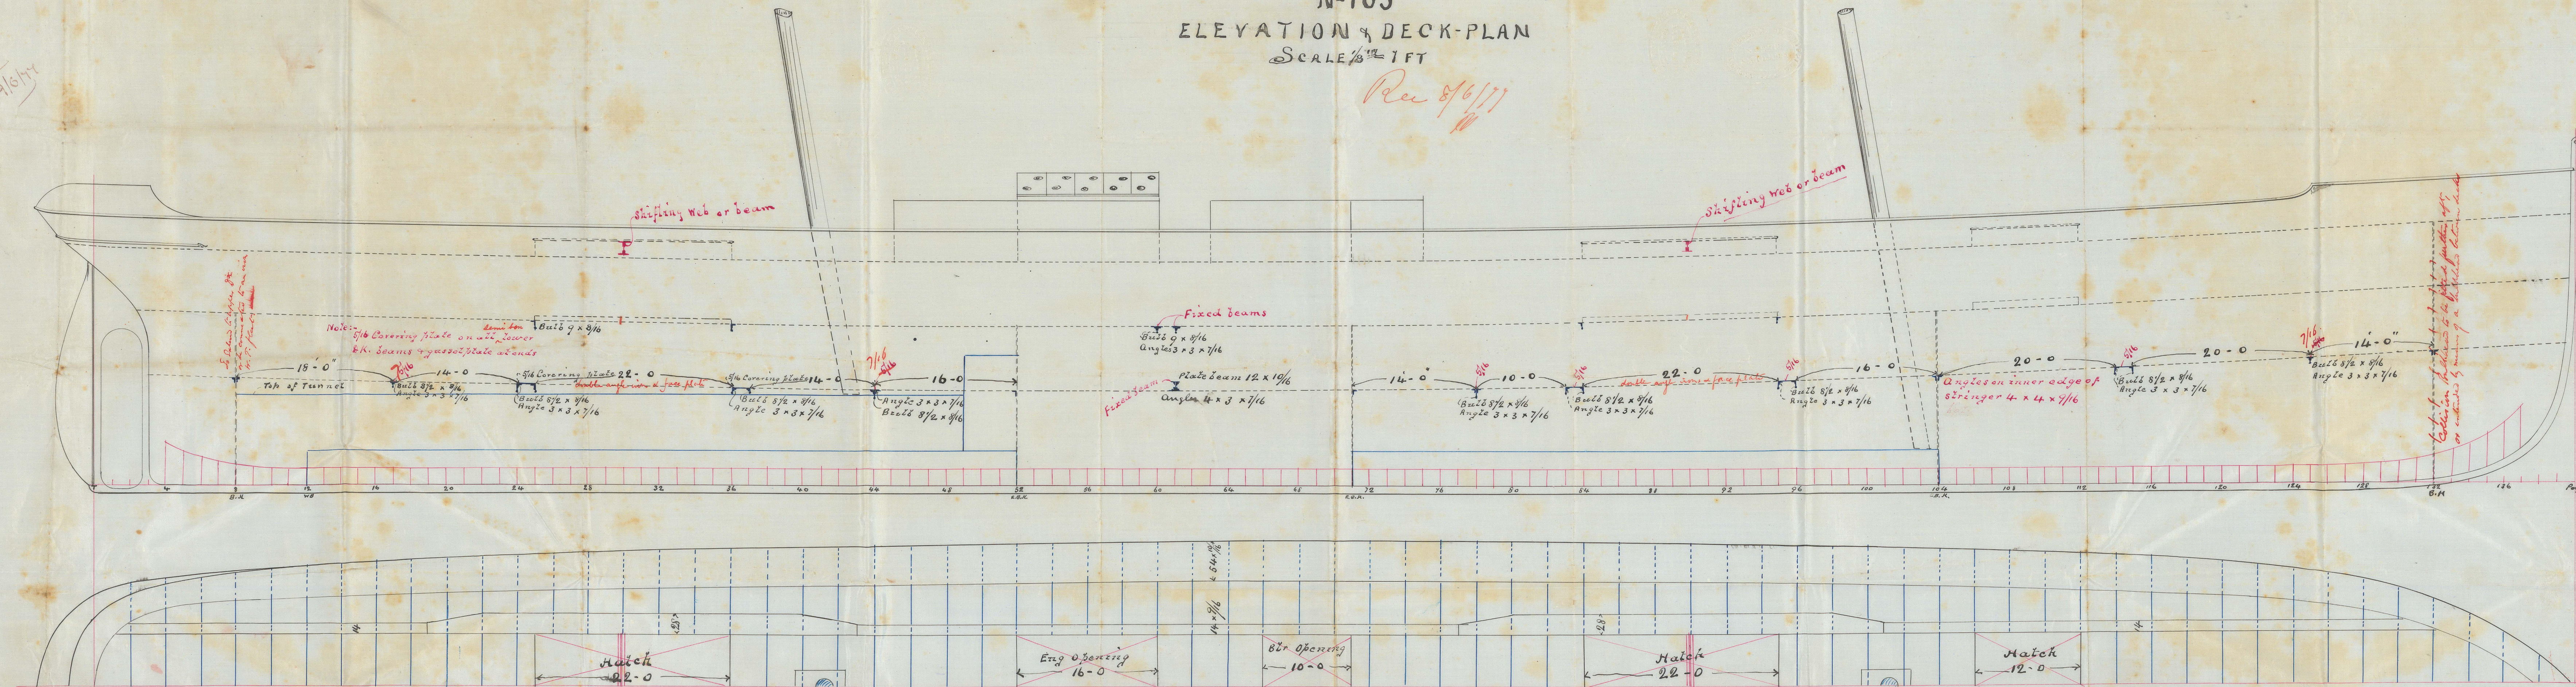

N.D.  
9/6/7

William Richardson  
 To Matthew 31 May 77