



3.6.80


Distribution of Butts
S.S. "Speedwell" NWC Report No. 15016

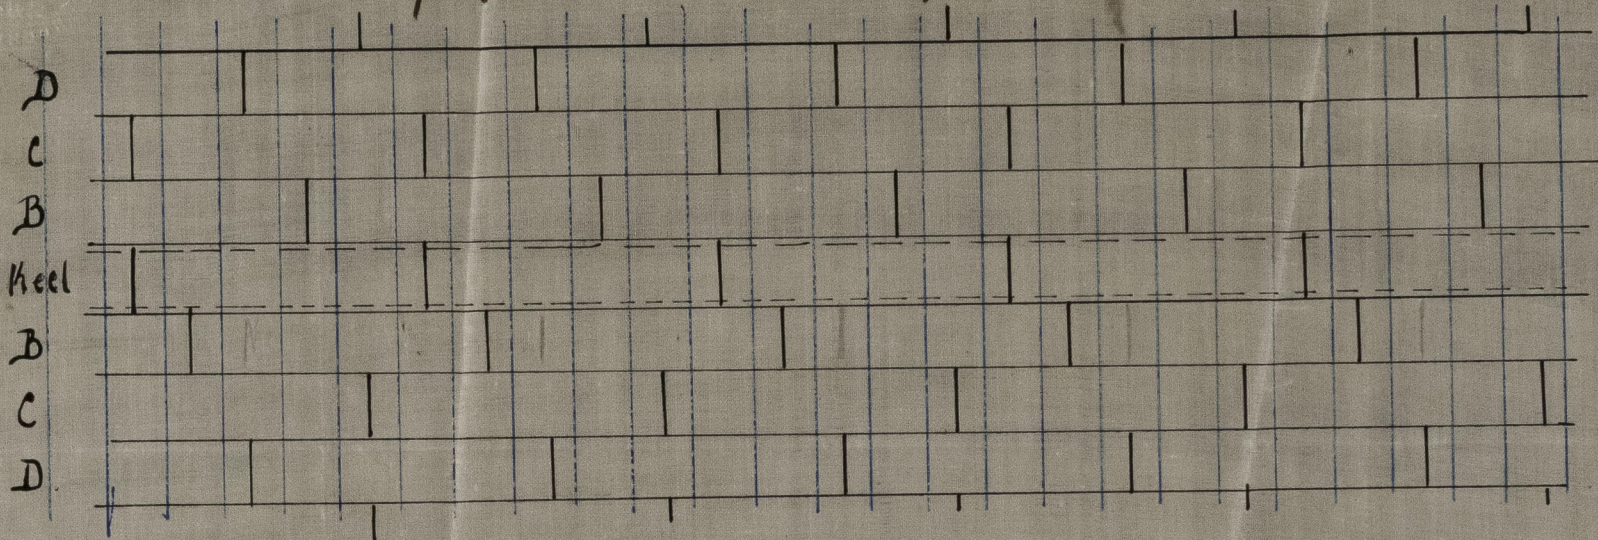

According to rule Garboard butts 2 frames from each other

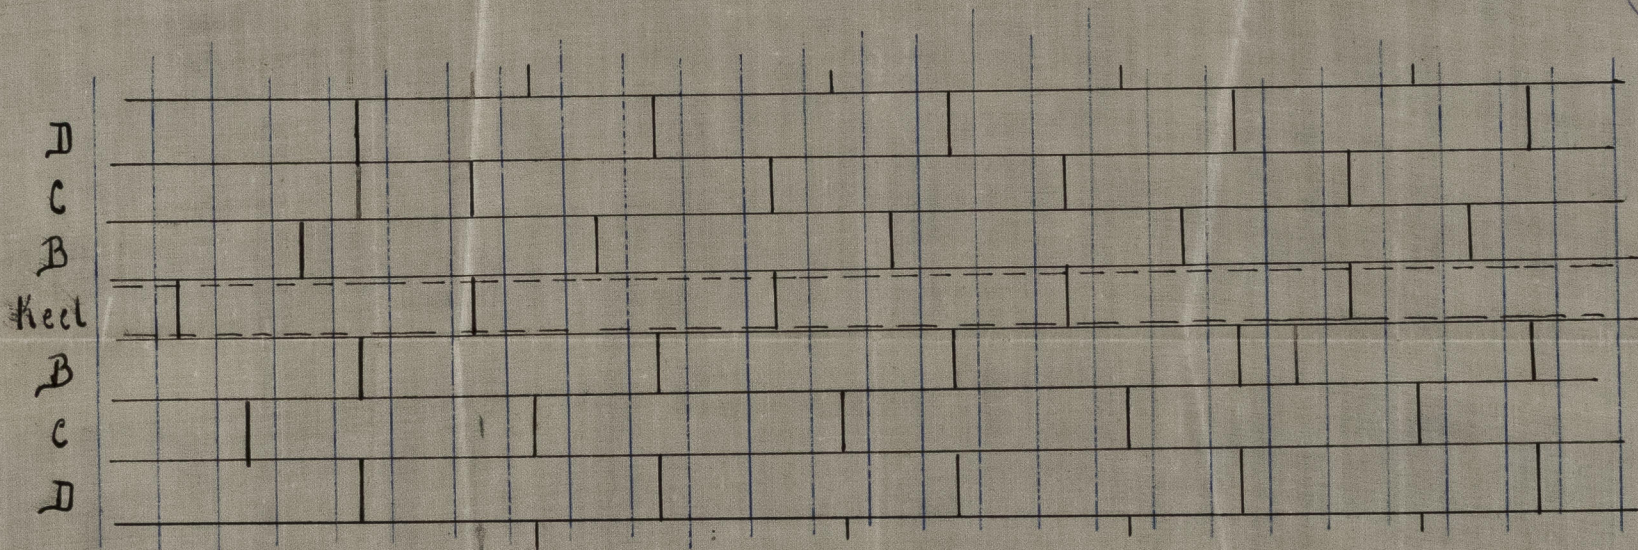

With Garboard & Keel shifted 2 frames
& " strakes 1 frame

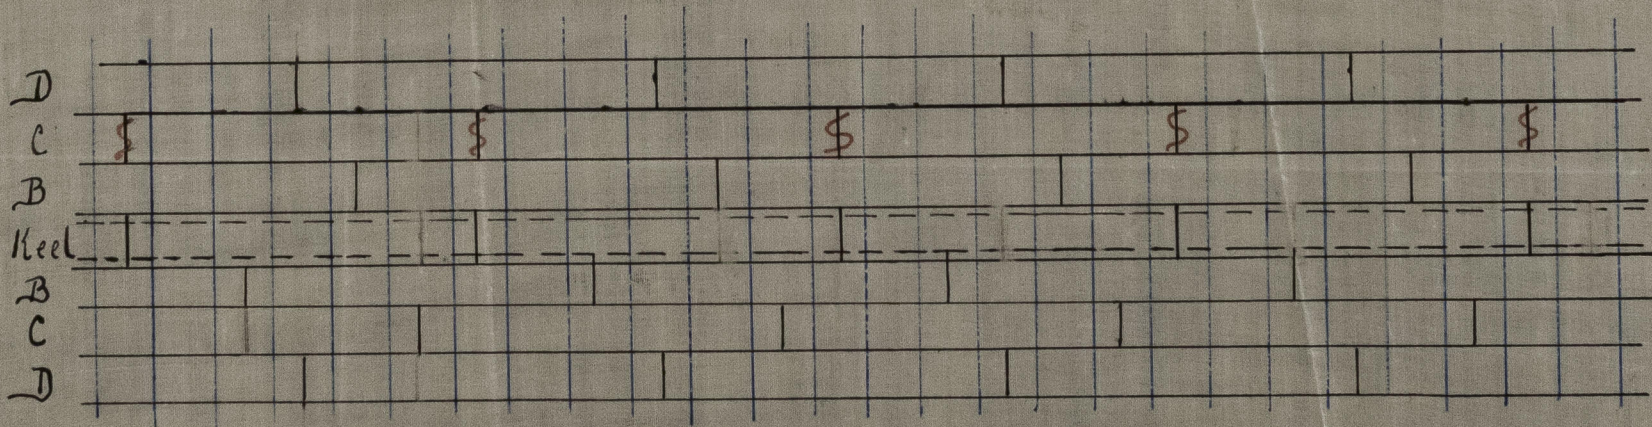

As in No 26 S & S



© 2021

Lloyd's Register
Foundation
3/6/80

180N544-0121