

STERN POST AND RUDDER FRAME FOR SS 66

FOR

WOODSIDE FERRY

Bebington


Iron No 28,308.

Approved
Tharish
Chairman
No 3.


Scale 1" to the foot.

29.1.80

22/1/80

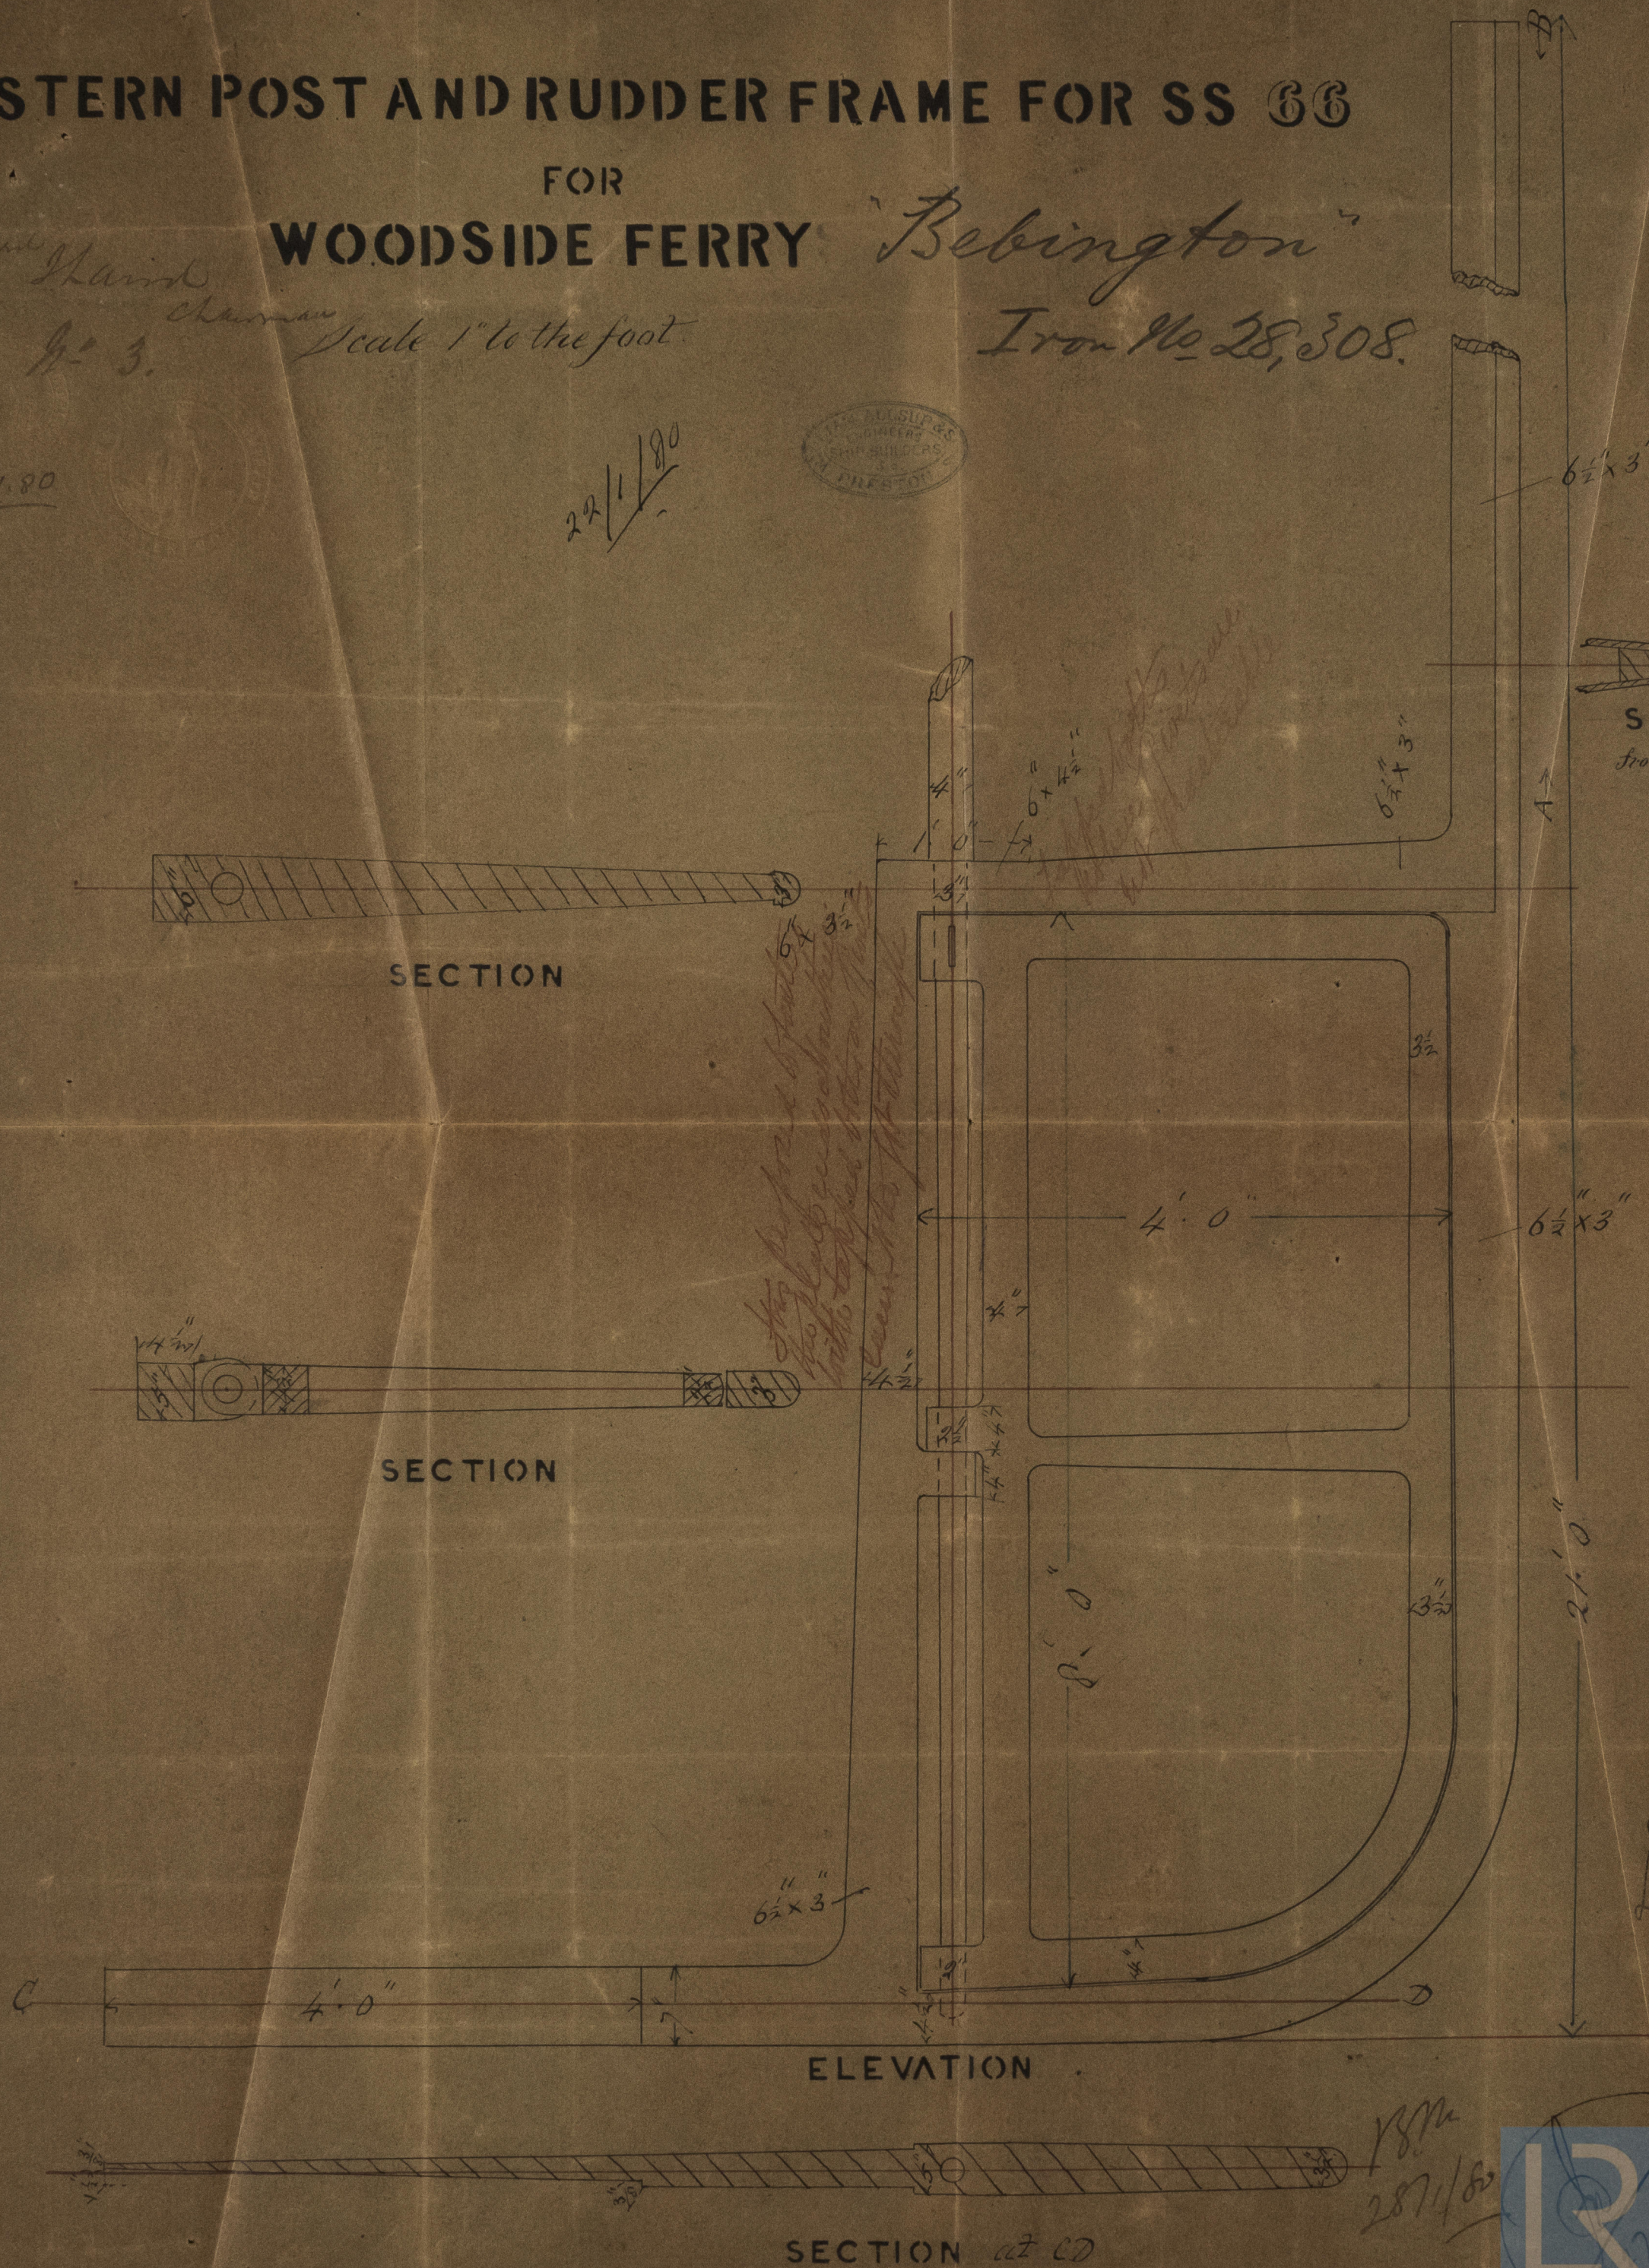

Lipool Jan 27/80
J. F. L.

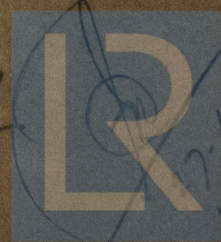

© 2021
Lloyd's Register
Foundation