


— MIDSHIP SECTION OF THE TWO FERRY STEAMERS "COUNTESS OF LATHOM" — LON 48880*
 — AND "COUNTESS OF ZETLAND" AS BUILT FOR THE GREENWICH FERRY CO. —
 LON 48881*

— SCALE 3/4 INCH = 1 FOOT. —

Chas. H. Jordan
 17 Dec. 88

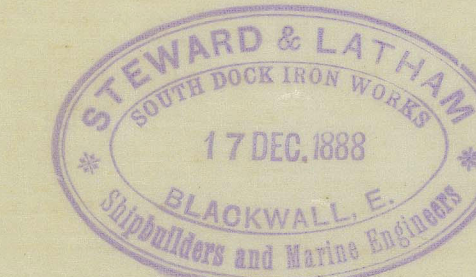

— PRINCIPAL DIMENSIONS. —

LENGTH OVER ALL	120' 0"
BREADTH TO OUTSIDE OF PLATES	90' 0"
DEPTH FROM TOP OF FLOORS TO TOP OF BEAMS	10' 1"
DO. MOULDED	10' 1"

Wood blocks of Pitch Pine 4" thick x 6" x 6" worked grain on end and laid in Portland Cement on the wood deck for smoothness.
 Wood deck of Pitch Pine 4" thick x 6" laid on the steel deck, and fastened with 1/2" iron bolts at fore and aft.
 Steel deck 3/4" thick all fore and aft.

