

The words FORGINGS or CASTINGS, IRON or STEEL, should be struck out as may be required.

London Ship Surveyor

Received at

Lloyd's Register of British and Foreign Shipping

Office. RECEIVED 21 JAN. 83 LONDON

(Report on Vessel No. Port)

No. *YYY.A*

SHIP FORGINGS OR CASTINGS.

RECEIVED 21 JAN. 83 LONDON

I have to report that the undermentioned Iron or Steel Forgings or Castings, manufactured by *Messrs R L Bagnall Sons* of *Hoyton* for the Vessel No. *Guinness Ferry Boat*, being built by *Messrs Steward & Latham* of *London* have been inspected by me as set forth below, and found to be, so far as can be seen, *sound*.


Mark on Forgings.

Lloyd's No. *YYYA* P.C.

Hugh Cameron
Sunderland
19/1/88
second

	STERN FRAME.	RUDDER FRAME.	STEM.
Material* - - - -		<i>Scrap iron</i>	
How made - - - -		<i>Forged</i>	
Dimensions - - - -		<i>as per sketch</i>	
Progress on Inspection -		<i>Forged & Smithed</i>	
Dates when Inspected		<i>Dec 30/87 Jan 6-10/88</i>	

SKETCHES OF FRAMES SHEWING POSITION AND DESCRIPTION OF WELDS OF FORGINGS, OR PARTICULARS OF TESTS APPLIED TO CASTINGS.

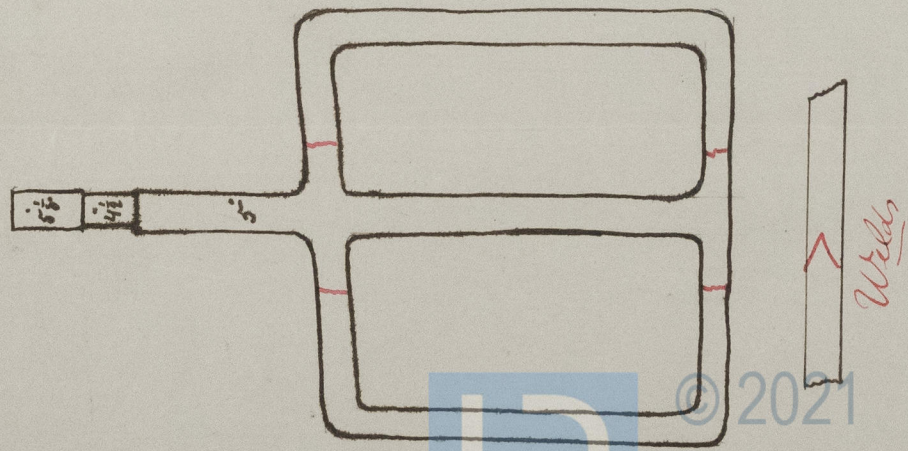

* If of Iron, state whether scrap or puddled iron.