

A.92
4/18/85
K. L. L.


— Scale $\frac{1}{4}$ " = 1000' —

CLASSED A FOR WOOLIGH FERRY PURPOSES ONLY

—LONGITUDINAL SECTION.—



—BRIDGE DECK

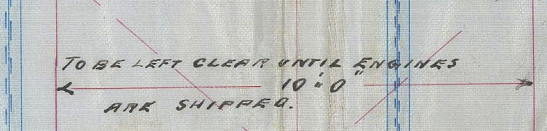

 © 2021
Lloyd's Register
Foundation

LON724-0024

Duncan Gordon

49282

ERRY BOATS

MENT

OUTPOSTS ONLY

SECTION



© 2021

Lloyd's Register
Foundation