

- S. S. No 13 -

- Proposed Topside Plating -

- Scale 2 in - One Ft -

FRI 9 NOV 89

MON

1 APR 89

SAT 2 JUN 89

MON 1 APR 89

WED 29 MAY 89

TUE 1 JUN 89

WED 18 JUN 89


Sheer 40" $\frac{10}{16}$ for $\frac{1}{2}$ Length
to $\frac{7}{16}$ at Ends
Butts double rivetted

$\frac{10}{16}$ for $\frac{1}{2}$ length to
 $\frac{7}{16}$ at Ends
Butts double rivetted

Sheer 40" $\frac{13}{16}$ for $\frac{1}{2}$ Length
to $\frac{7}{16}$ at Ends
Butts treble rivetted
in way of Oil Tanks

$\frac{10}{16}$ for $\frac{1}{2}$ Length
 $\frac{8}{16}$ at Ends
Butts treble rivetted
in way of Oil Tanks

all shell butts to be treble
rivetted in way of Oil Tanks

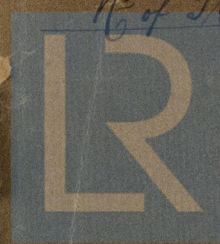

No of Tracing 683

Lloyd's Register
Foundation


HD0739/93

S/S Lancaster N^o 73

Hpl Rept 7

S/S Leicester N^o 16

S/S Prudence N^o 18

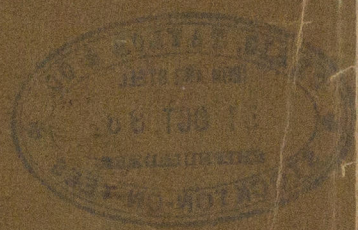

© 2019

Lloyd's Register
Foundation

MS737/93