


SCALE  $\frac{1}{8}$  INCH = 1 FOOT

See Amended Schedule

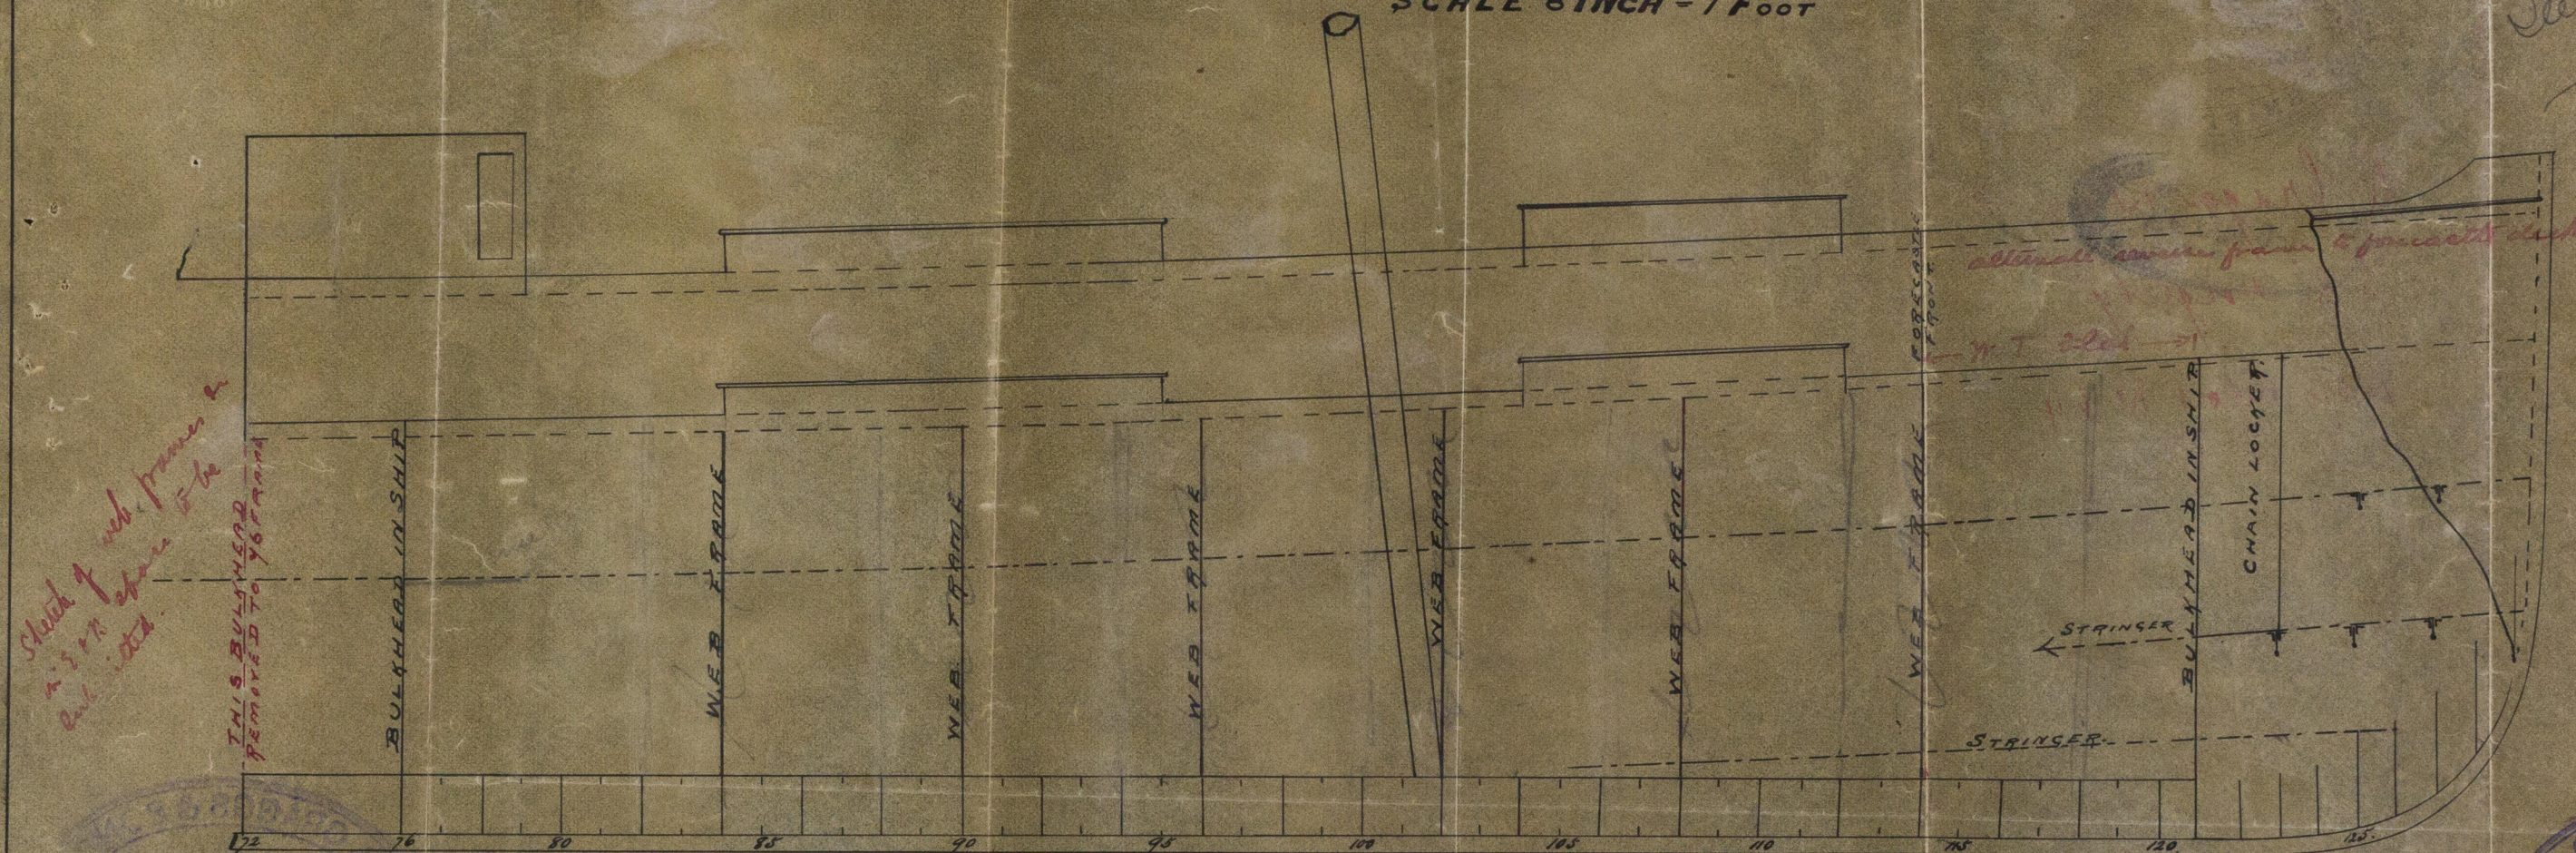

Sketch of sub. frames &  
in 2 x 12 before 15 hr  
and after.

THIS BULKHEAD  
REMOVED TO 46 FRAM

BULKHEAD IN SHIP

WEST FARM

WEB FRAME

WED FIVE

WEB FRAME

NEW FRAME

WEST FORD

BUCKHEAD INSHIR

CHAIN LOCATED

STRINGS

STRINGER



DDLESBROOK  
Register  
Foundation  
MAB739/14




LLOYD'S REGISTER OF SHIPPING  
RECEIVED  
5 NOV. 89  
LONDON

283M

LLOYD'S REGISTER OF  
ROYAL EXCHANGE  
MIDDLESBROUGH-ON-TEES  
SHIPPING

R. Craggs & Sons 85  
S. B. Ingleby

Intro Report No 64

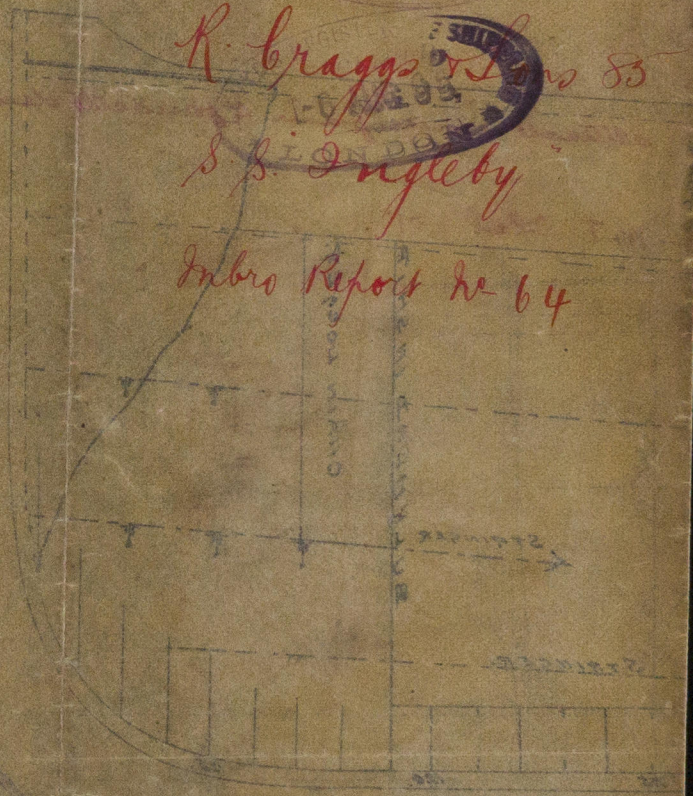

LLOYD'S REGISTER OF SHIPPING  
MIDDLESBROUGH-ON-TEES  
ROYAL EXCHANGE  
SHIPPING



© 2019

Lloyd's Register  
Foundation