


Arrangement for strengthening at break of Raised Quarter D^k

Scale $\frac{1}{2}$ inch to one Foot.

Longitudinal Section at Middle line.



TUE 19 NOV 89

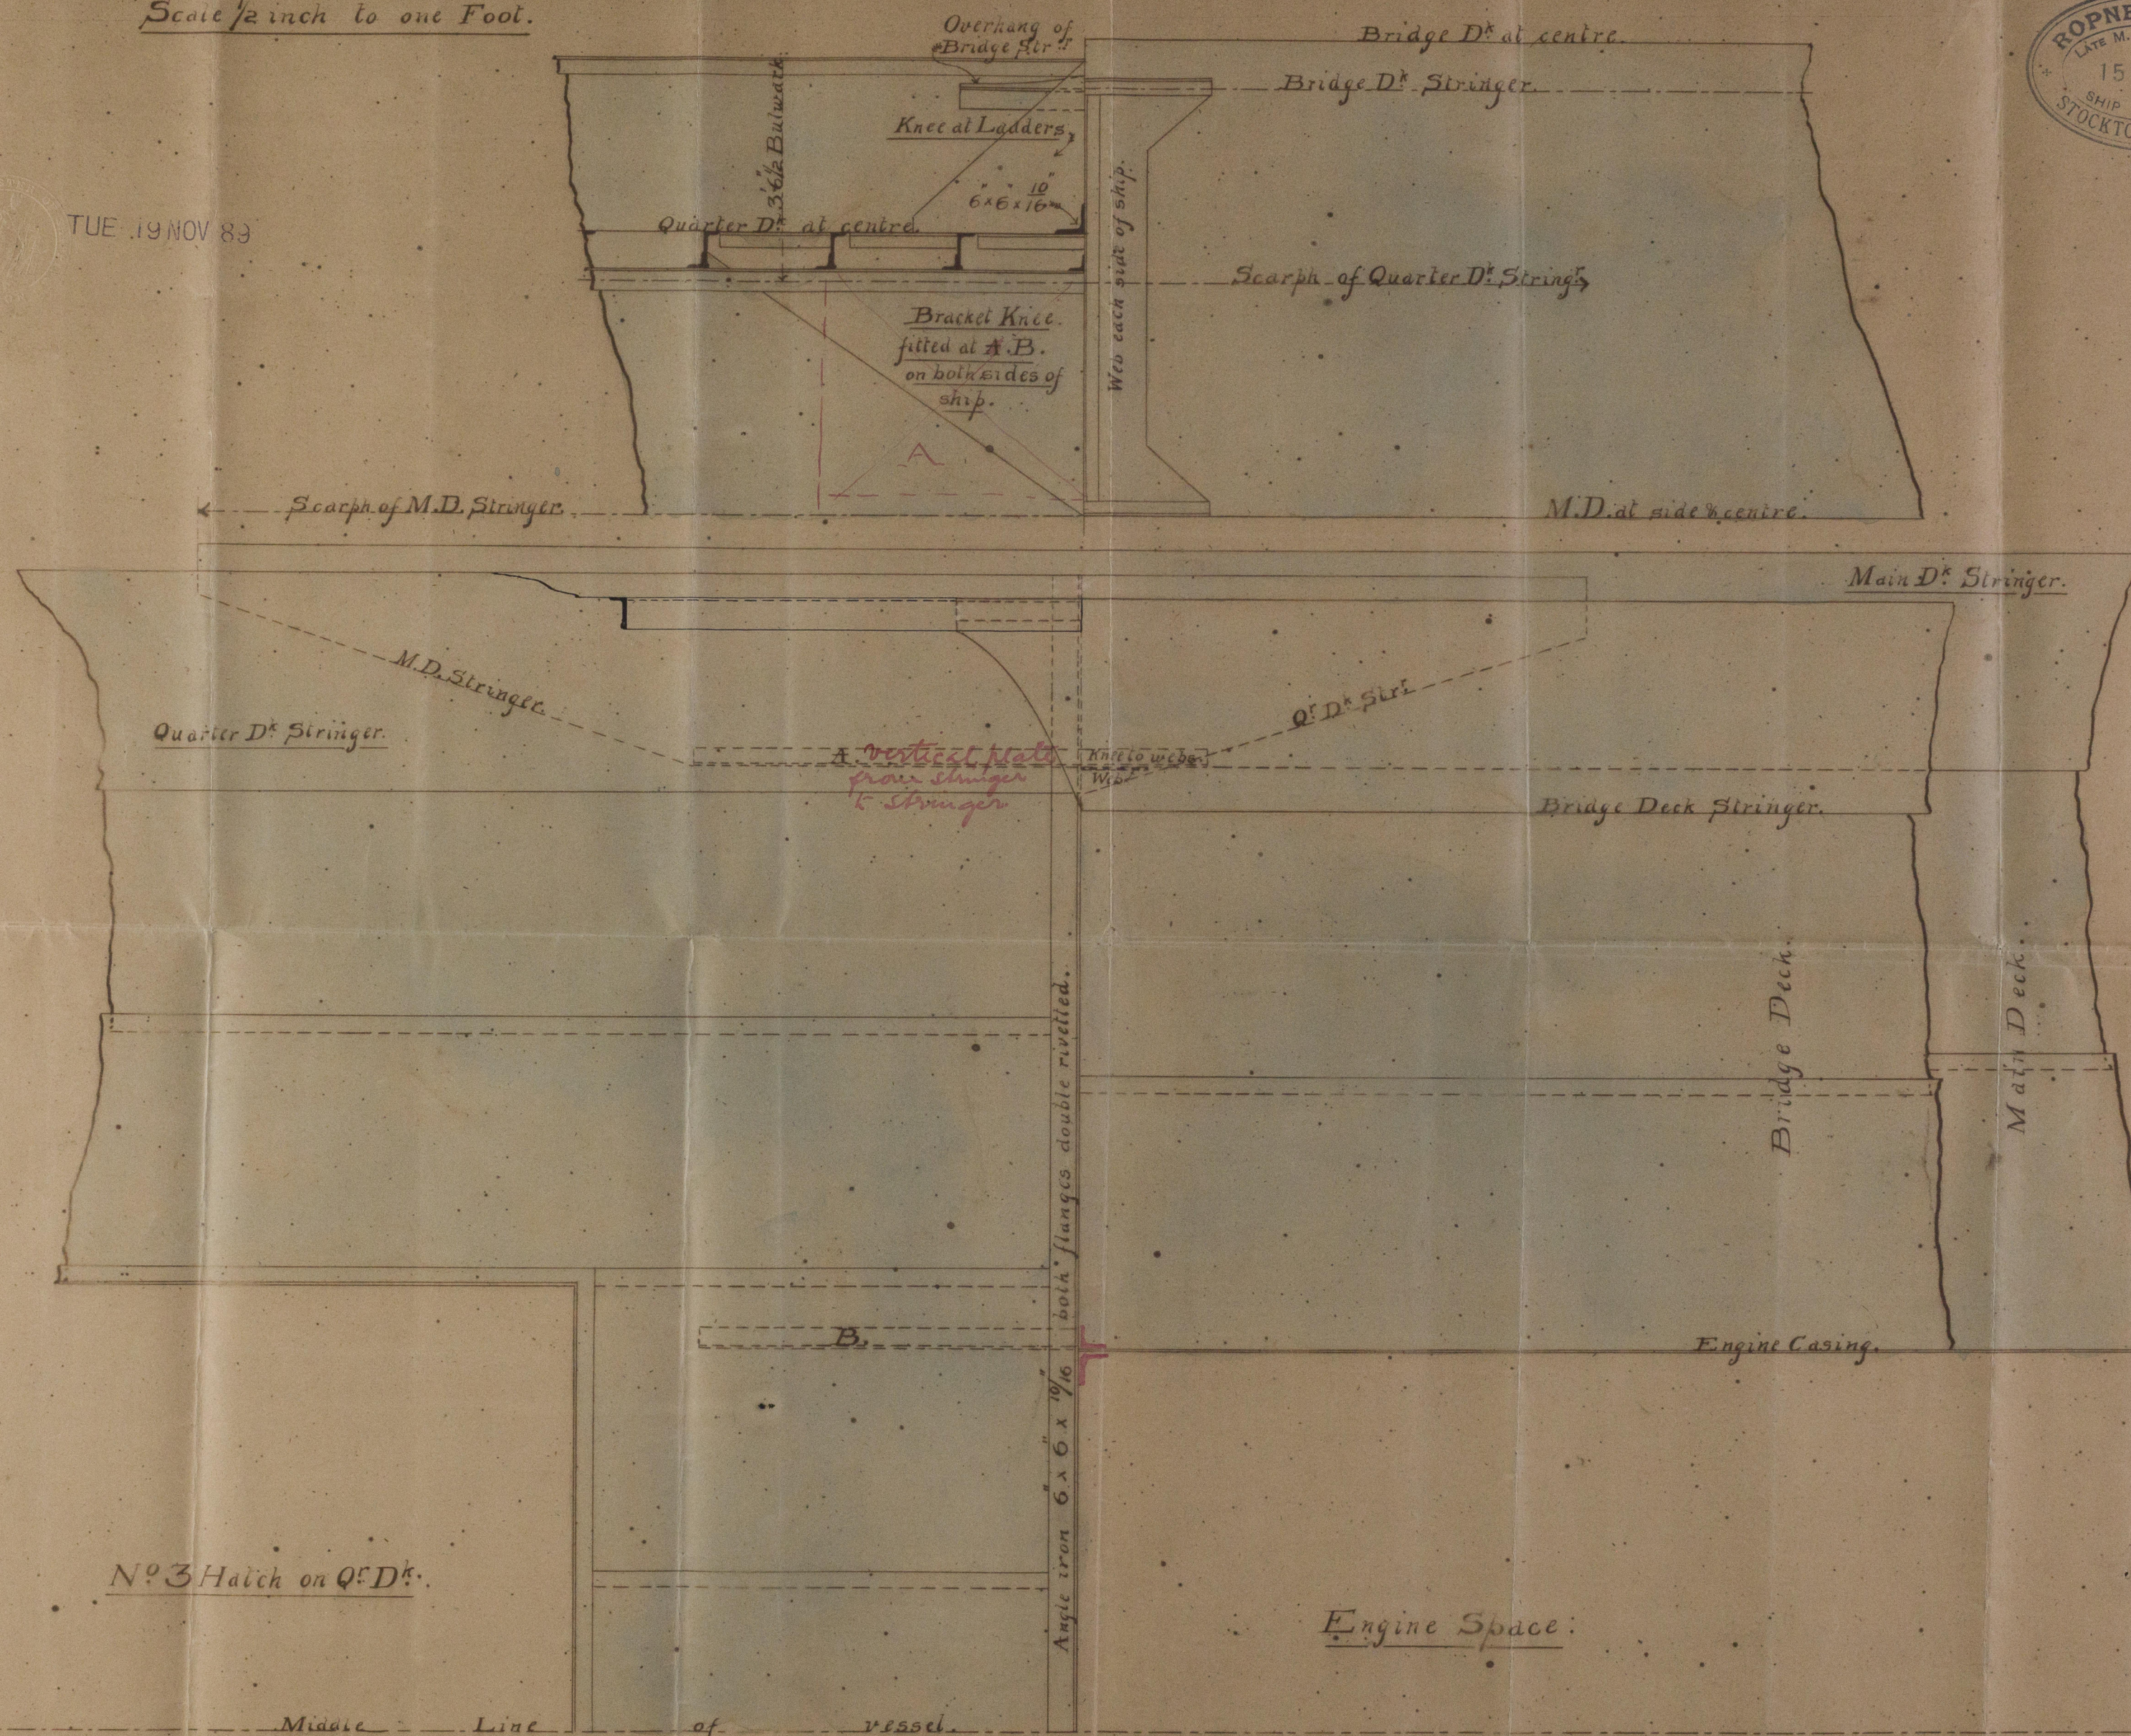


Plan.

J.H.
187
1/11/89


Rapner's

N. 246

S. S. Theres Heymann

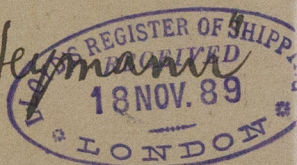

Intro Report N^o 68

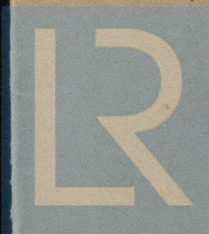

© 2019

Lloyd's Register
Foundation

MDB739/159