

STEEL-TWIN-SCREW STEAMER.

LENGTH	190.0
BREADTH	28.6
DEPTH MOULDED.	8.6"


No 122.

THU 15 SEP 89
FRI 20 SEP 89
MON 14 OCT 89
FRI 21 FEB 90


30 August 89

512

SCALE $\frac{1}{8} = 1$ FOOT.

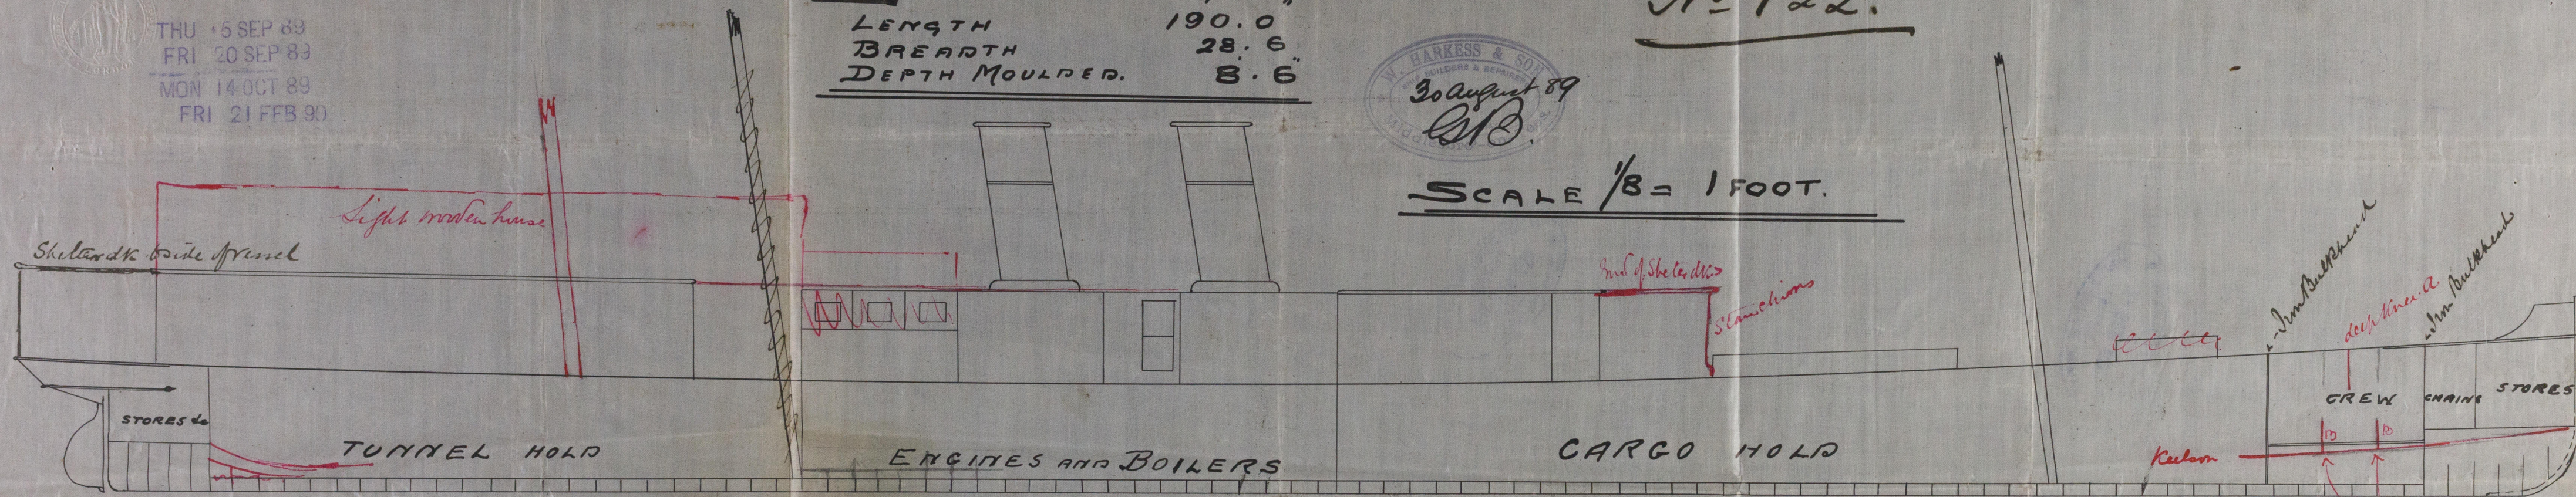

STEEL DECK $\frac{1}{2}$ LENGTH AMIDSHIPS



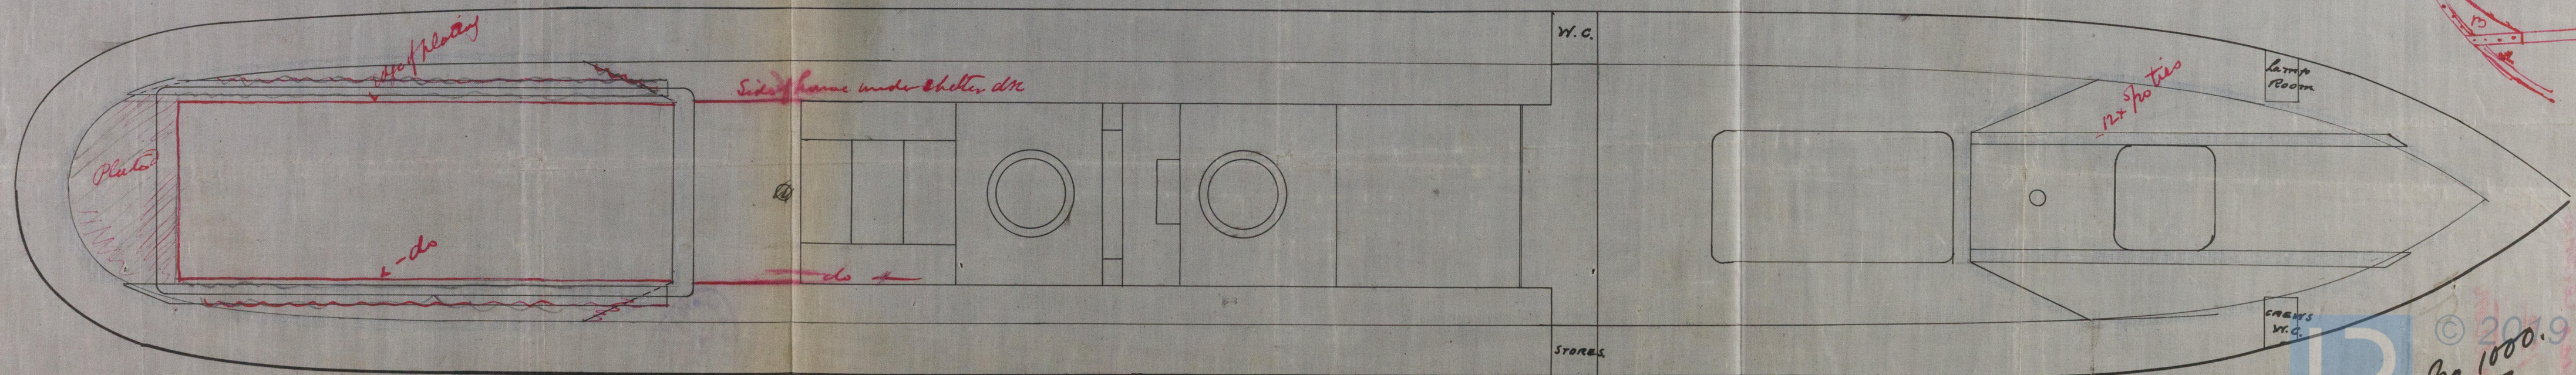


© 2009
Lloyd's Register
Foundation

MDB739/278

MSA 731/279



H. Harassett & Sons
Mtro
S.S. Elisa Cerano
No 122
Elevation.
Mtro 91

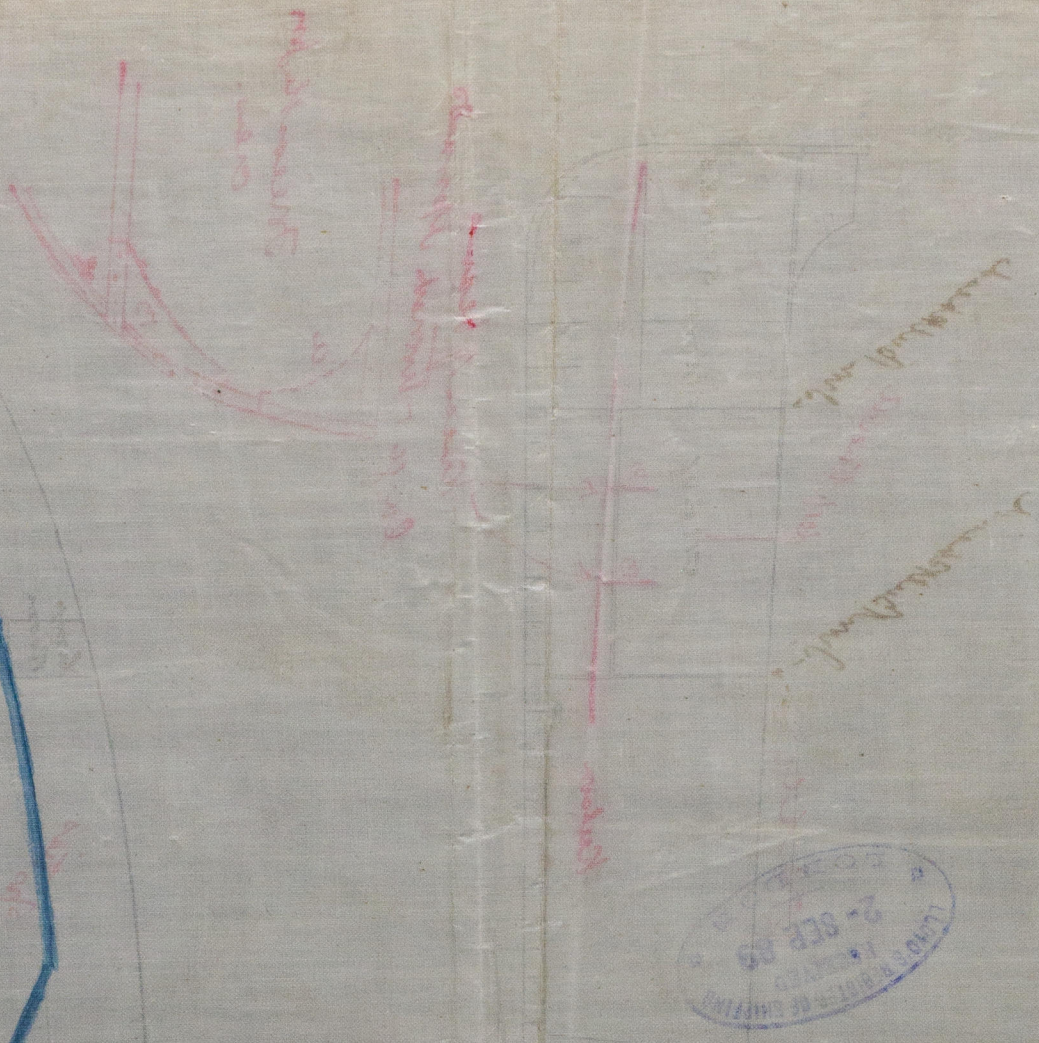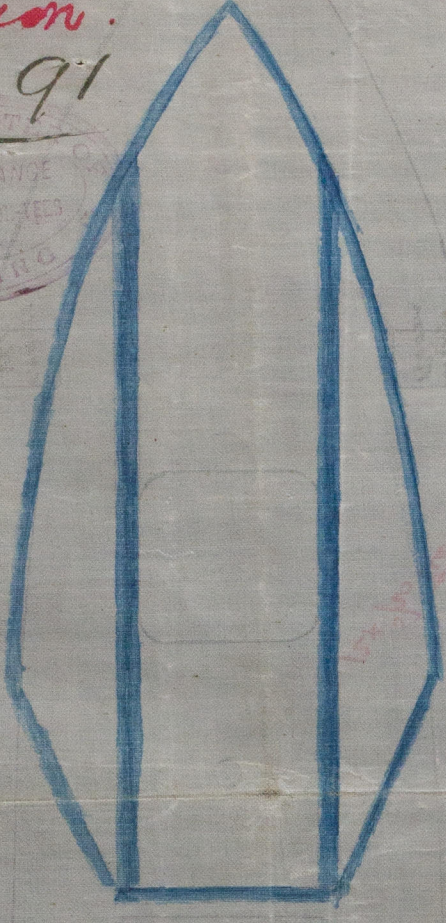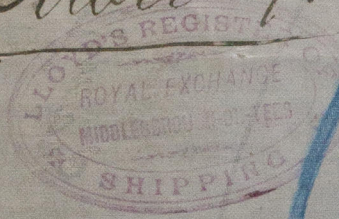

S.S. 101



See also drawing in file

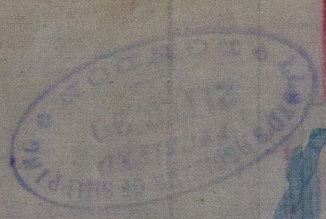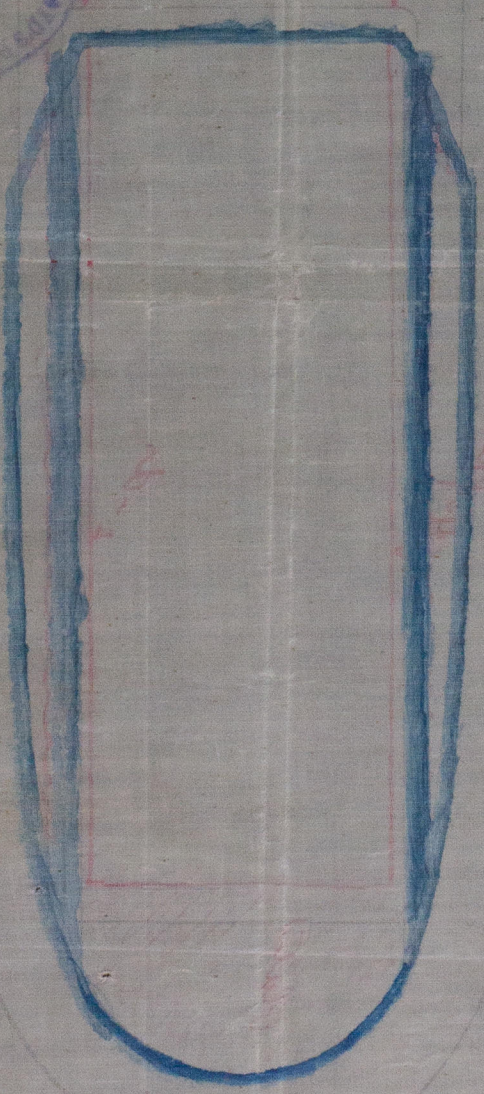

ENR 1226 1917
ENR 1220 1917
ENR 1221 1917
ENR 1212 1917



See 12
1889 OCT 1