


PLAN SHEWING ADDITIONAL DECK HOUSE + EXTENSION OF SHADE DECK.

S.S. NO 122.


SCALE $\frac{1}{8}$ " = ONE FOOT.

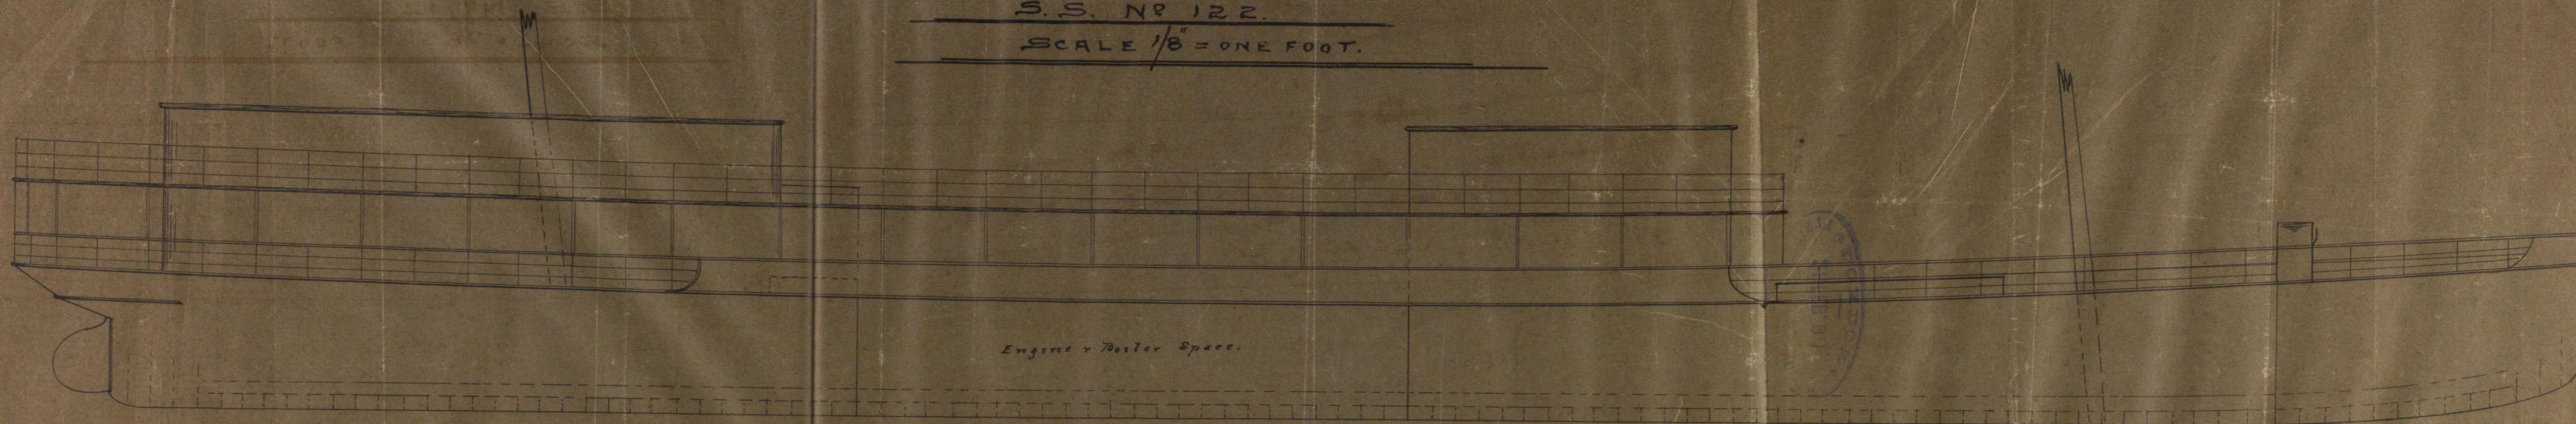


SECTION THRO' AFTER DECK HOUSE.



SECTION THRO' MIDSHIP DECK HOUSE.

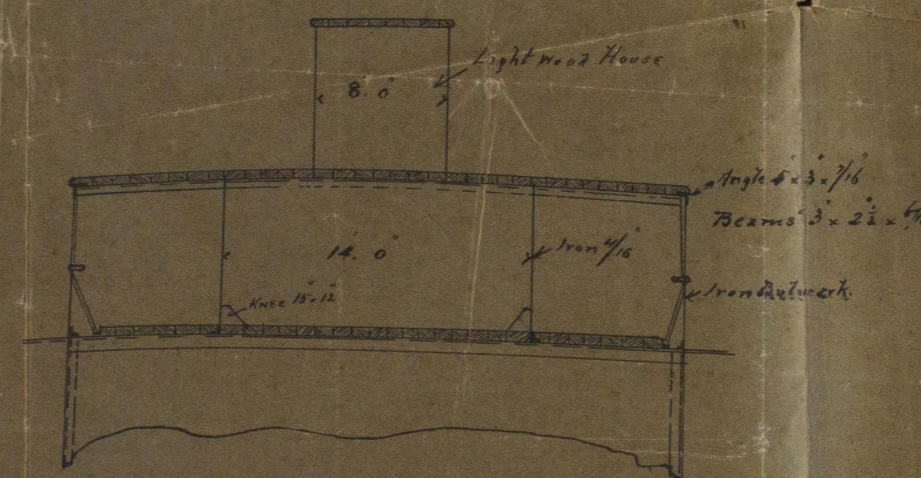

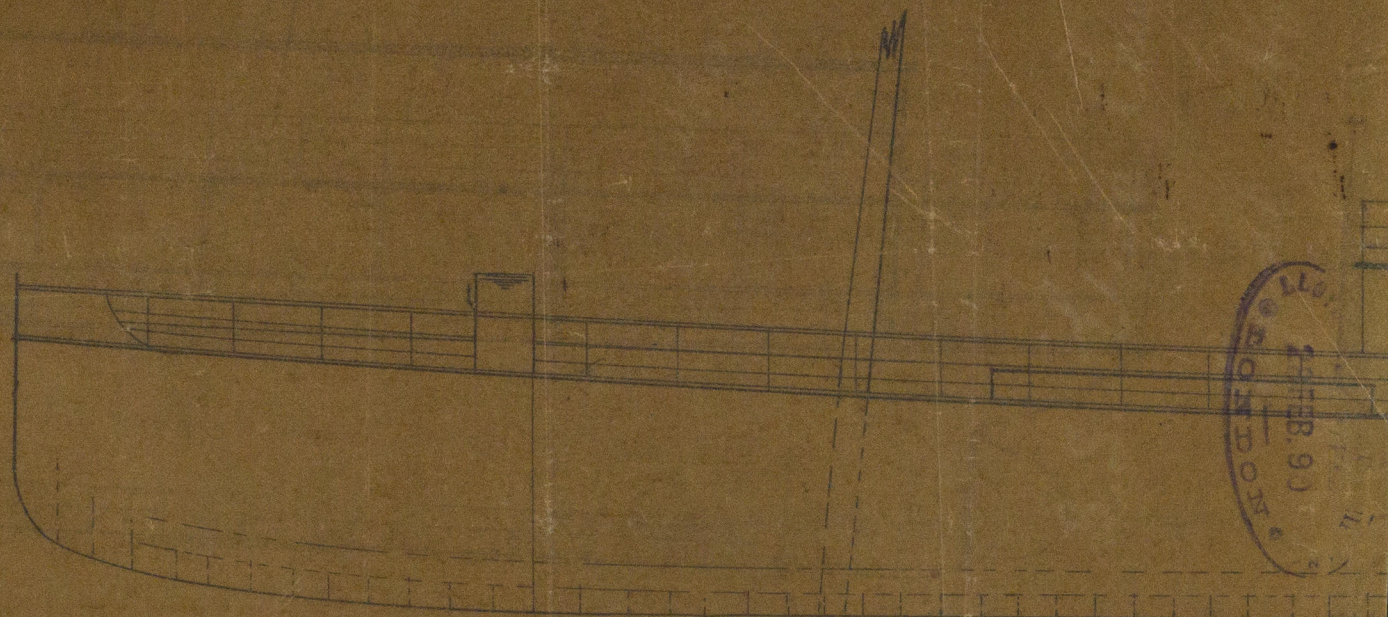


Mr. Harkness & Son
Middlebury

SS. Eliza Cerana
No 122

Elevation of houses &c

March 91

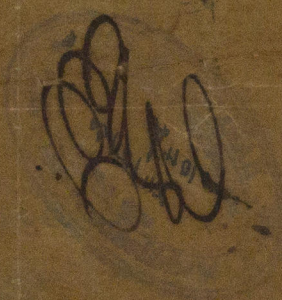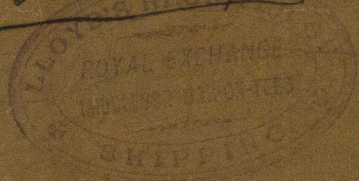

© 2019

Lloyd's Register
Foundation