


PLAN OF MASTS

SCALE 1/2 INCH TO ONE FOOT

Masts to be made on 2 plates in circumference, outside strake to be on fire side of mast as shown
Buttclaps to be 1/2 thicker than the plates they connect & filled inside
1 plate edges riveted with 5/8 inch, round single rivets
Rivets in butt & edges spaced 5 diameters apart centres

ROPER & SON
30 OCT. 89
FOREMAST

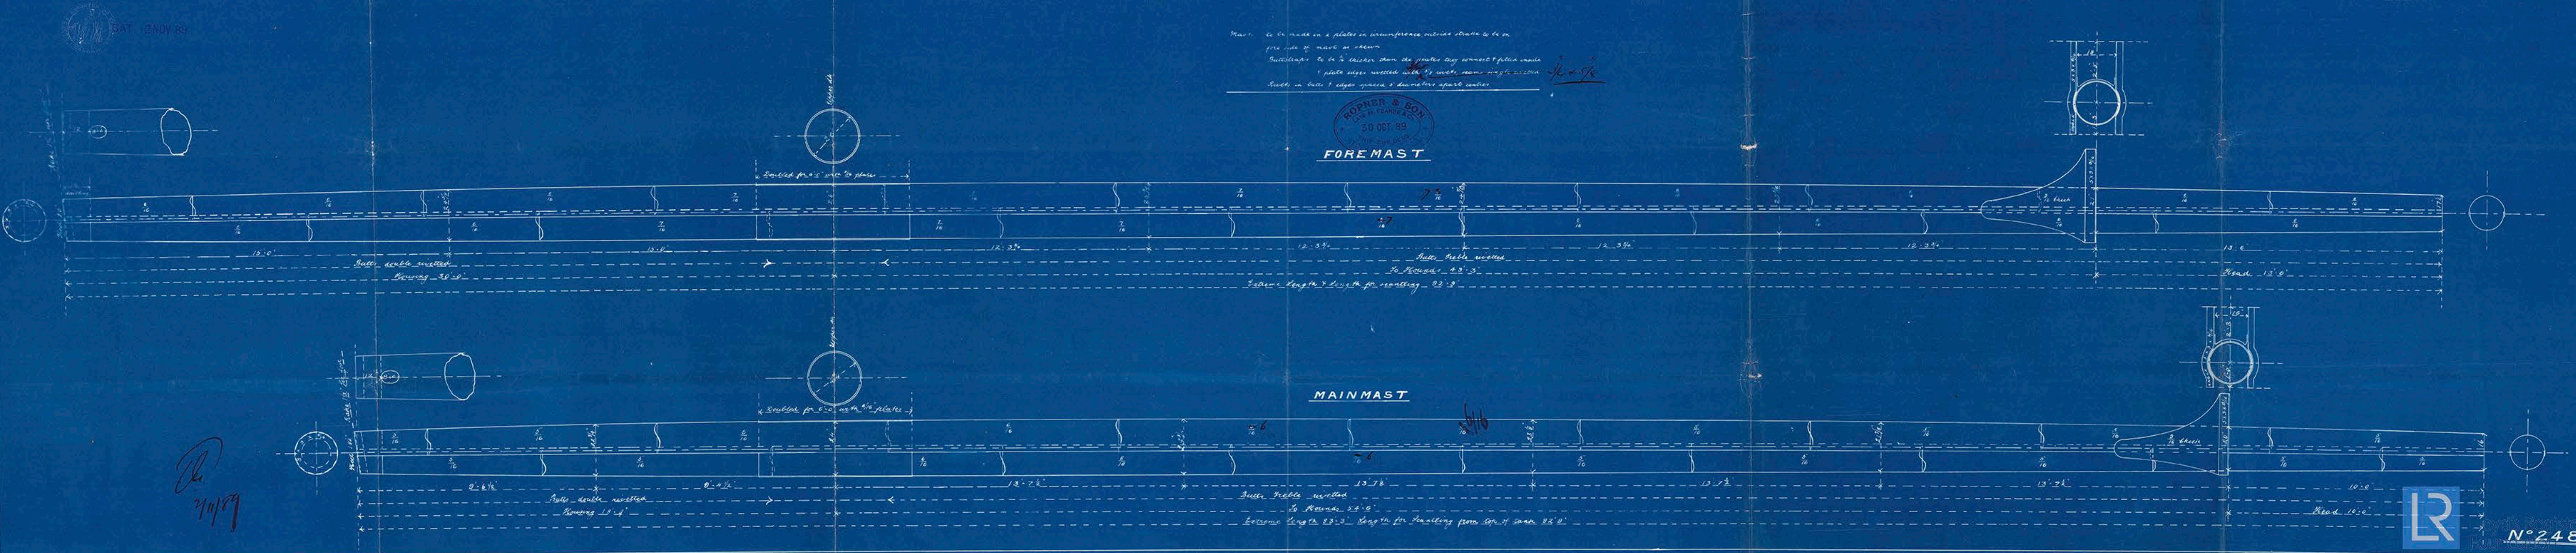

Master plan of
Inver. Kopner & Sons N° 248
S.S. "Pakeha"
Intro Report N° 153



© 2018

Lloyd's Register
Foundation

MD3740/32