

*S. S. Dunbeth* Received at *Middlesbro'* Office, *22<sup>nd</sup> Aug 1890*  
**Lloyd's Register of British and Foreign Shipping.**  
 (Report on Vessel No. *328* Port *Middlesbro'*)

*No. 352* **SHIP FORGINGS OR CASTINGS.**

I have to report that the undermentioned Iron or ~~Steel~~ Forgings or Castings, manufactured by  
*The Jarrow Forge Co* of *Jarrow*  
 for the Vessel No. *22*, being built by *Messrs Craig Taylor & Co*  
 of *Stockton* have been inspected by me as set forth below, and found  
 to be, so far as can be seen, *sound*

The words FORGINGS or CASTINGS, IRON or STEEL, should be struck out as may be required.


Mark on Forgings.

**Lloyd's**  
 No. *8713*  
*JH*

*John C Craig*  
*Newcastle*  
*16/8/90*

	STERN FRAME.	RUDDER FRAME.	STEM.
Material* . . . . .	<i>Scrap iron</i>	<i>Scrap iron</i>	
How made . . . . .	<i>Forged</i>	<i>Forged</i>	
Dimensions . . . . .	<i>10 - 5 1/2</i>	<i>7 3/4 - 3 3/4</i>	
Progress on Inspection .	<i>Forged &amp; Smithed</i>	<i>Forged &amp; Smithed</i>	<i>Not seen</i>
Dates when Inspected {	<i>Feb 6-10-13 March 14 June 17-23-July 30</i> <i>22-28 May 6-9/90 August 1-5-7/90</i>		

SKETCHES OF FRAMES SHEWING POSITION AND DESCRIPTION OF WELDS OF FORGINGS, OR PARTICULARS OF TESTS APPLIED TO CASTINGS.

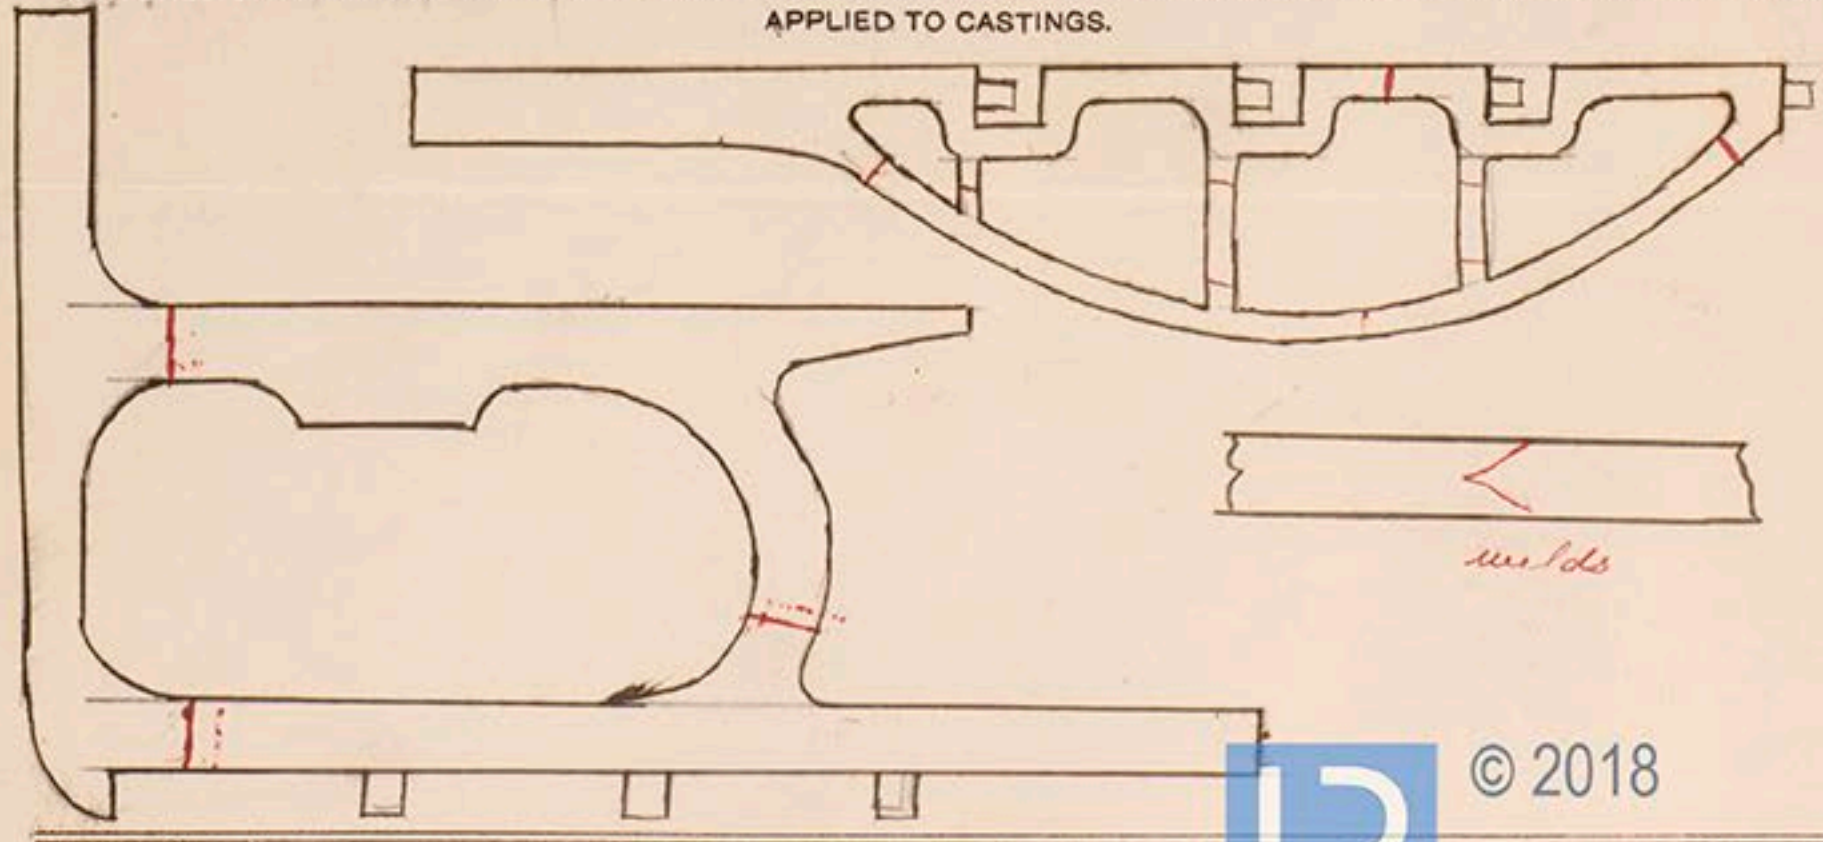

\* If of Iron, state whether scrap or puddled iron.

