

S.S. "Pala"

Received at Middlesboro office, 26<sup>th</sup> November 1890

# Lloyd's Register of British and Foreign Shipping.

Middlesboro

(Report on Vessel No. 333 Port Wboro.)

No. 1733.a.

## SHIP FORGINGS OR CASTINGS.

I have to report that the undermentioned Iron or Steel Forgings or Castings, manufactured by

The Stockton Forge Co. of Stockton

for the Vessel No. 383, being built by Messrs Richardson Duck & Co.

of Stockton have been inspected by me as set forth below, and found

to be, so far as can be seen, sound

The words FORGINGS or CASTINGS, IRON or STEEL, should be struck out as may be required.

Mark on Forgings.


Lloyd's  
No. 1733a  
St. C.

Joseph Cameron

Sunderland  
25-11-90

|                        | STERN FRAME.                   | RUDDER FRAME.                                                  | STEM.           |
|------------------------|--------------------------------|----------------------------------------------------------------|-----------------|
| Material*              | <u>Scrap iron</u>              | <u>Scrap iron</u>                                              |                 |
| How made               | <u>Faced</u>                   | <u>Faced</u>                                                   |                 |
| Dimensions             | <u>10' x 6"</u>                | <u>7<sup>3</sup>/<sub>4</sub> - 3<sup>3</sup>/<sub>4</sub></u> |                 |
| Progress on Inspection | <u>Smoothed</u>                | <u>Faced &amp; smoothed</u>                                    | <u>not seen</u> |
| Dates when Inspected   | <u>Aug 26-29 Sept 13-22/90</u> | <u>Oct 10-17-21-30 Nov 4</u><br><u>7-10-21/90</u>              |                 |

SKETCHES OF FRAMES SHEWING POSITION AND DESCRIPTION OF WELDS OF FORGINGS, OR PARTICULARS OF TESTS APPLIED TO CASTINGS.

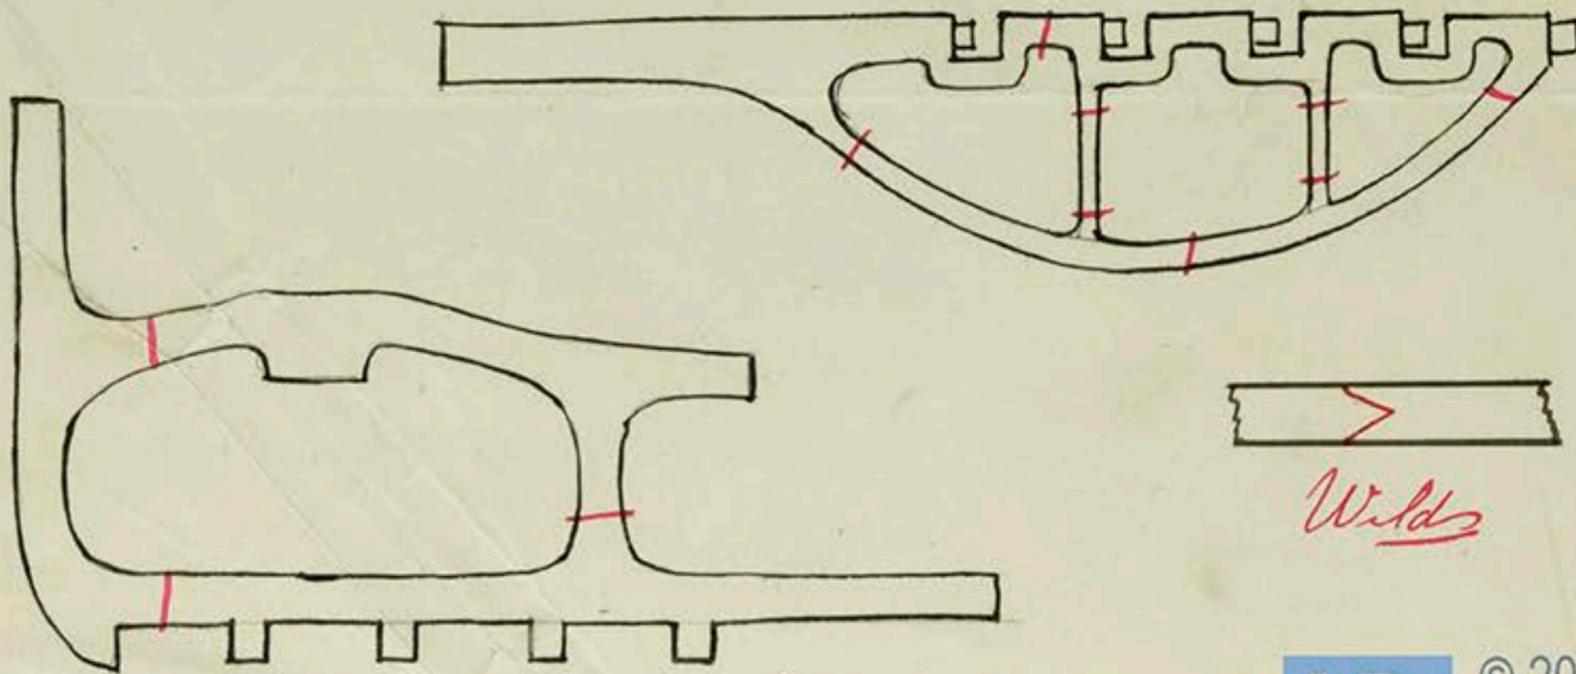

1733

\* If of Iron, state whether scrap or puddled Iron.



© 2018

Lloyd's Register Foundation