

Principal dimensions.


Scantling Numbers

| | | |
|--------------|------------------------------------|----------------|
| Half Breadth | 18' 2" | Length 270' 0" |
| Depth | 19' 10 1/2" assuming 9' camber | 1' 6" |
| Half girth | 34' 3 1/2" | 268' 6" |
| | 42' 4" x 268' 6" = 19420 Scantling | |
| | 21847 Equipment | |

| | |
|-----------------|---|
| Length B. | 270' 0" |
| Breadth extreme | 36' 6" |
| Depth in hold | 17' 8 1/2" Lloyd's Floors 6' 6" to Tank Top |
| Depth mould | 19' 1 1/2" |

Class - O A 1 Lloyd's.
Scale 1 foot.

Proportions
Depths in Length 13' 7"
Breadths " 7' 3"

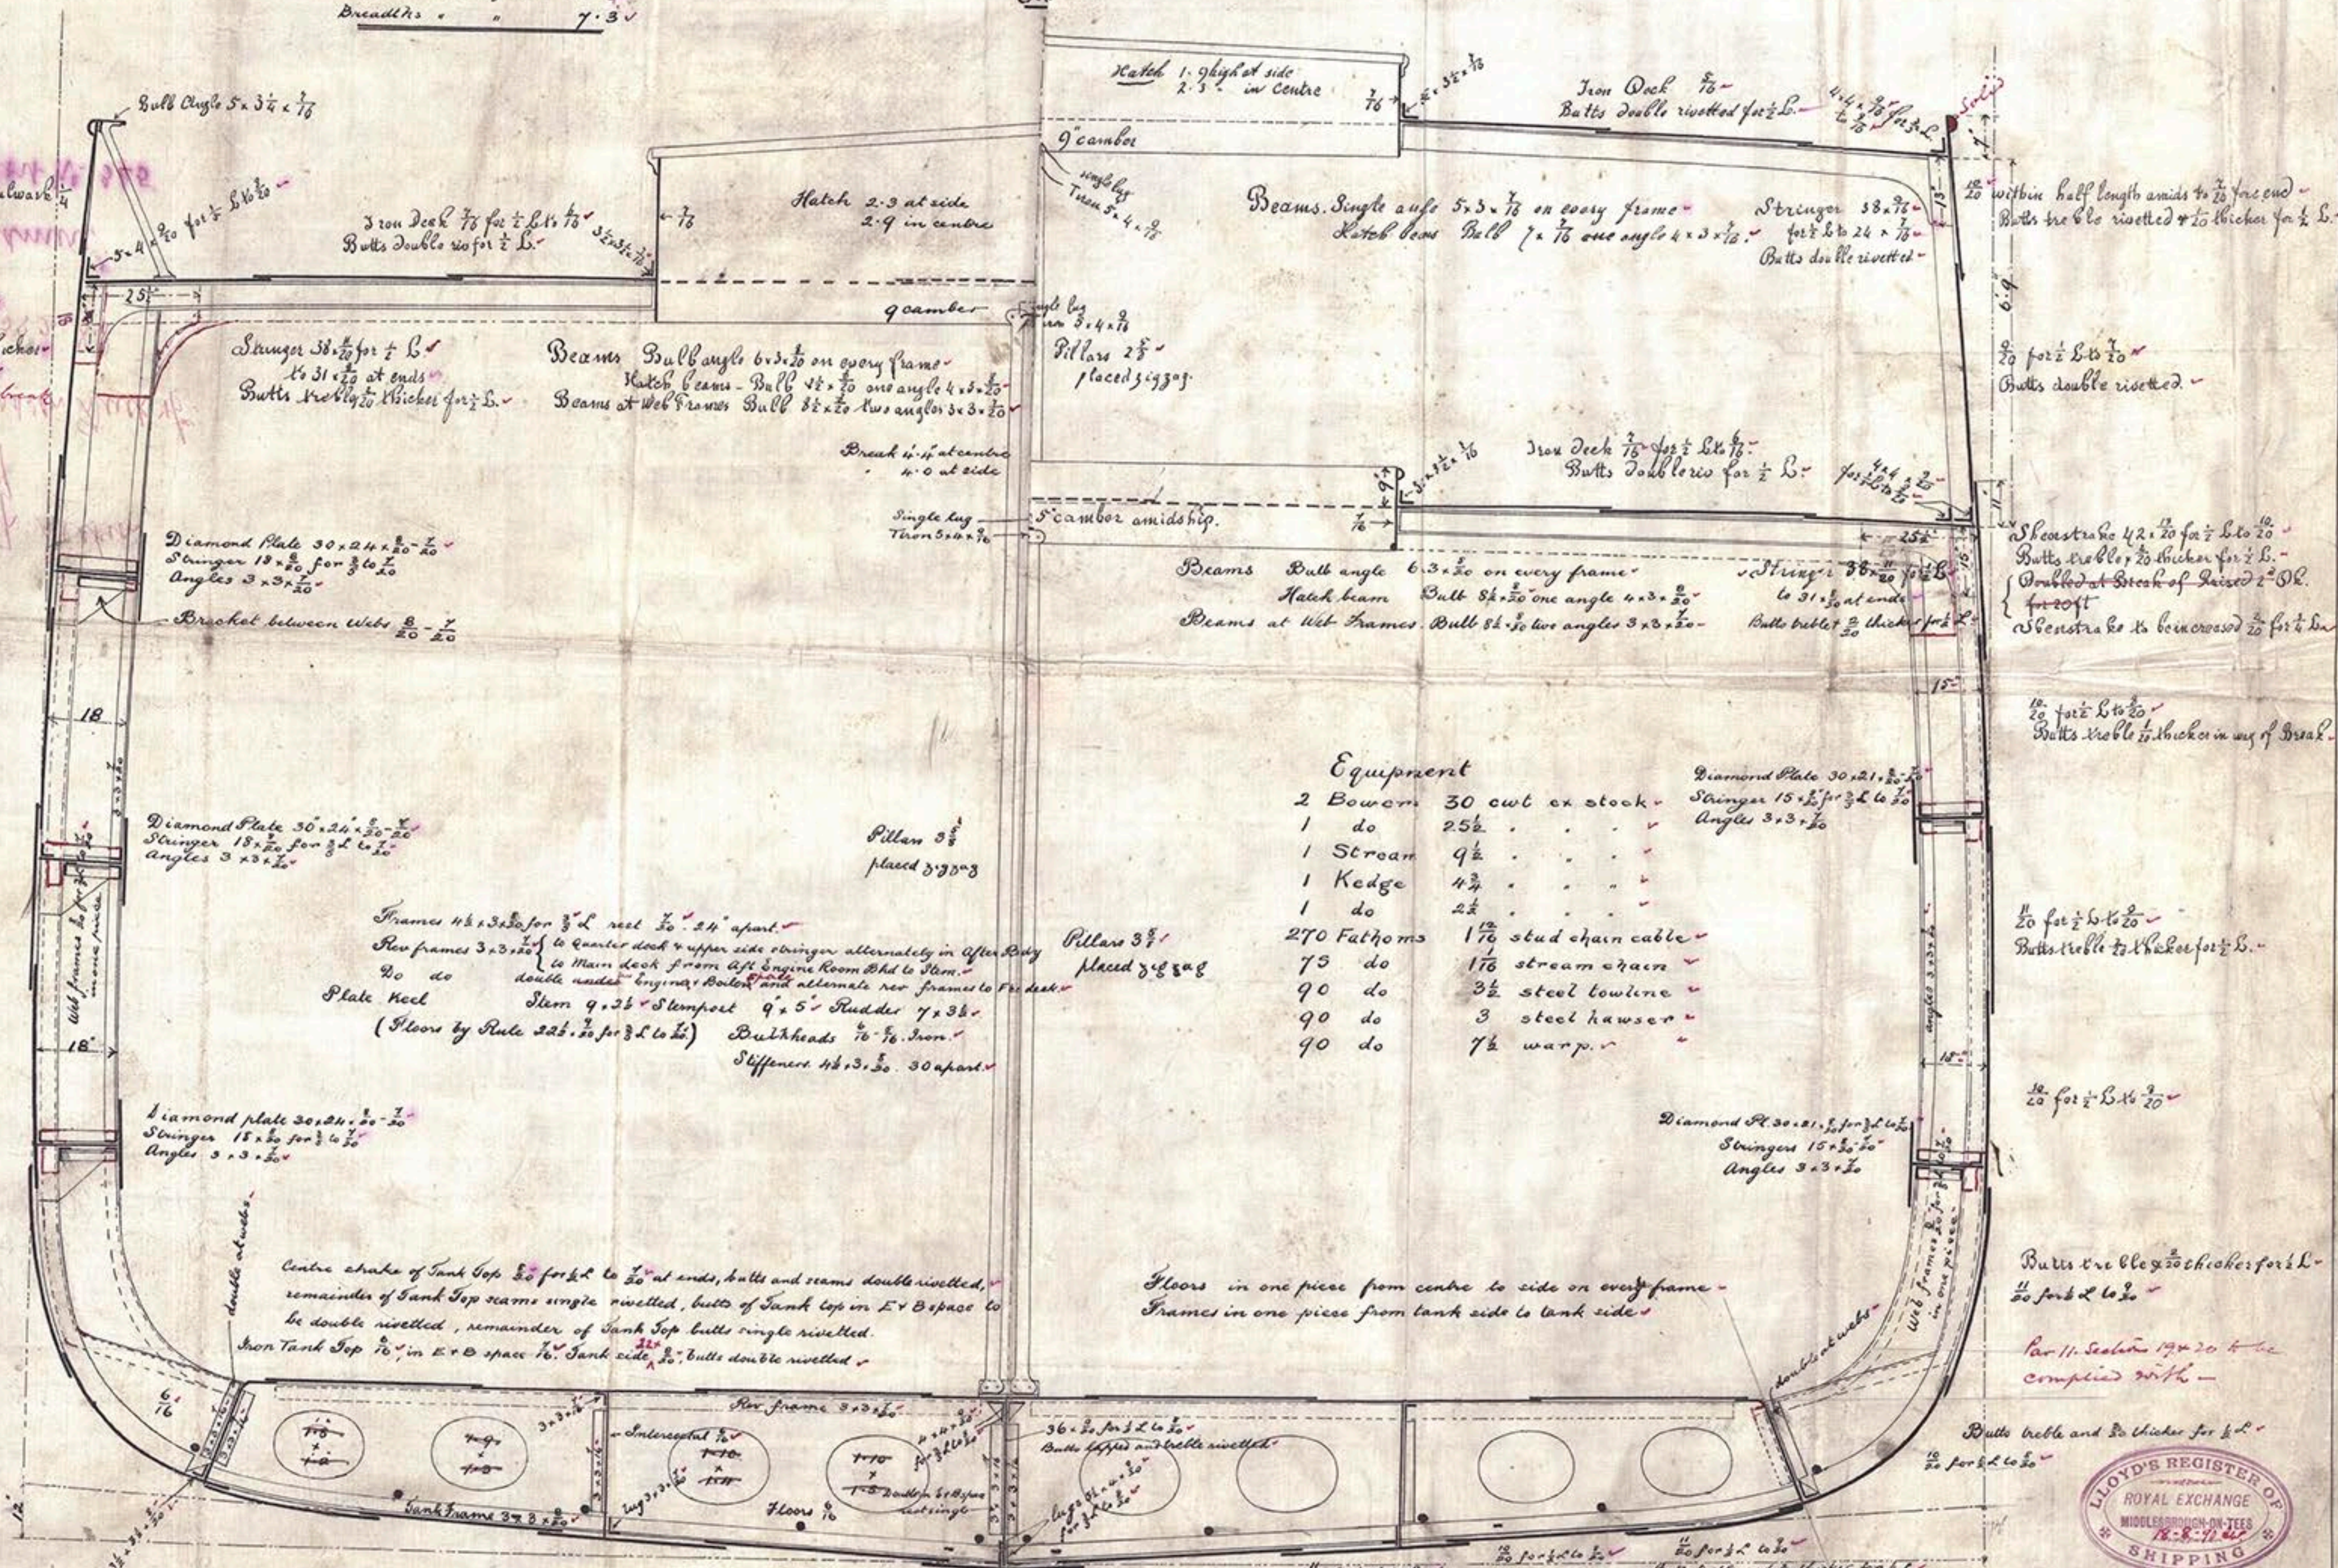

Equipment

| | | |
|-------------|-----------------|--------------------------------------|
| 2 Bower | 30 cwt ex stock | Diamond Plate 30 x 24 x 3/16 |
| 1 do | 25 1/2 | Stringer 15 x 3/4 for 3/4 L to 3/4 L |
| 1 Stroom | 9 1/2 | Angles 3 x 3 x 1/2 |
| 1 Kedge | 4 1/2 | |
| 1 do | 2 1/2 | |
| 270 Fathoms | 1 1/2 | stud chain cable |
| 75 do | 1 1/2 | stream chain |
| 90 do | 3 1/2 | steel towline |
| 90 do | 3 | steel hawser |
| 90 do | 7 1/2 | warp |

Floors in one piece from centre to side on every frame
Frames in one piece from tank side to tank side



No 382

Lloyd's Register Foundation

Midship Section
of

Mess. Richardson Duck & Co.

No. 382 S.S.

S.S. Sledmere

Intro Report No. 345

MED 1 OCT 80

WOM 12 FEB 80

THE 30 MAR 80




© 2018

Lloyd's Register
Foundation

MA/30