

S.S. Alton Lower

Received at Middlesbro Office, 21st Feb. 18 91.

Lloyd's Register of British and Foreign Shipping.

Middlesbro

(Report on Vessel No. 363 Port Mbto.)

No. 1781a.

SHIP FORGINGS OR CASTINGS.

I have to report that the undermentioned Iron or ~~Steel~~ Forgings or Castings, manufactured by

The Stockton Forge Co. of Stockton

for the Vessel No. 256, being built by Imp^r Robner Sons

of Stockton have been inspected by me as set forth below, and found

to be, so far as can be seen, sound.

The words FORGINGS or CASTINGS, IRON or STEEL, should be struck out as may be required.

Mark on Forgings.

Lloyd's
No. 1781a
No. 6.


Wm Cameron

London

20.2.91

	STERN FRAME.	RUDDER FRAME.	STEM.
Material*	<u>Scrap iron</u>	<u>Scrap iron</u>	
How made	<u>Forged</u>	<u>Forged</u>	
Dimensions	<u>10'6"</u>	<u>8'-4"</u>	
Progress on Inspection	<u>Smithed</u>	<u>Forged & smithed</u>	<u>not seen</u>
Dates when Inspected	<u>Oct 10 17/90</u>	<u>Jan'y 7-12-21-27-30</u>	

SKETCHES OF FRAMES SHEWING POSITION AND DESCRIPTION OF WELDS OF FORGINGS, OR PARTICULARS OF TESTS APPLIED TO CASTINGS.

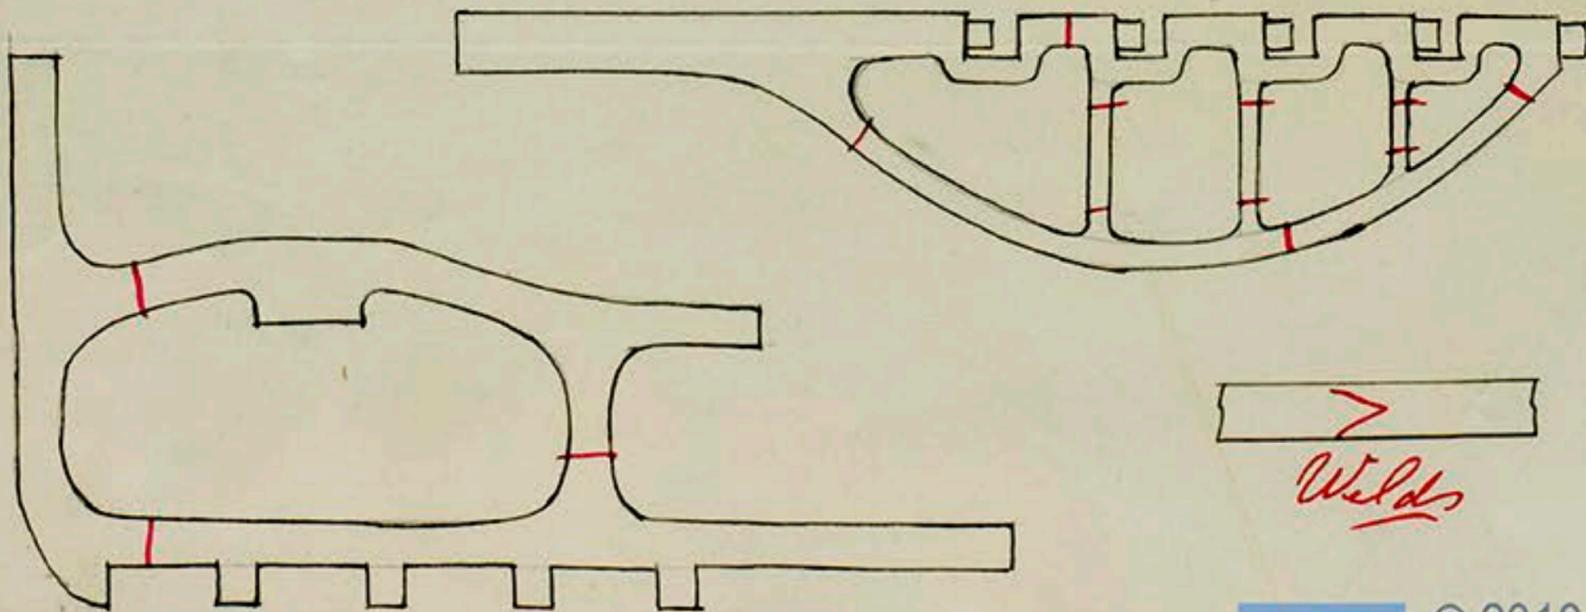

* If of Iron, state whether scrap or puddled Iron.