


*Geo. B. Builders*  
TUE 2 DEC 90

BRIDGE DECK.


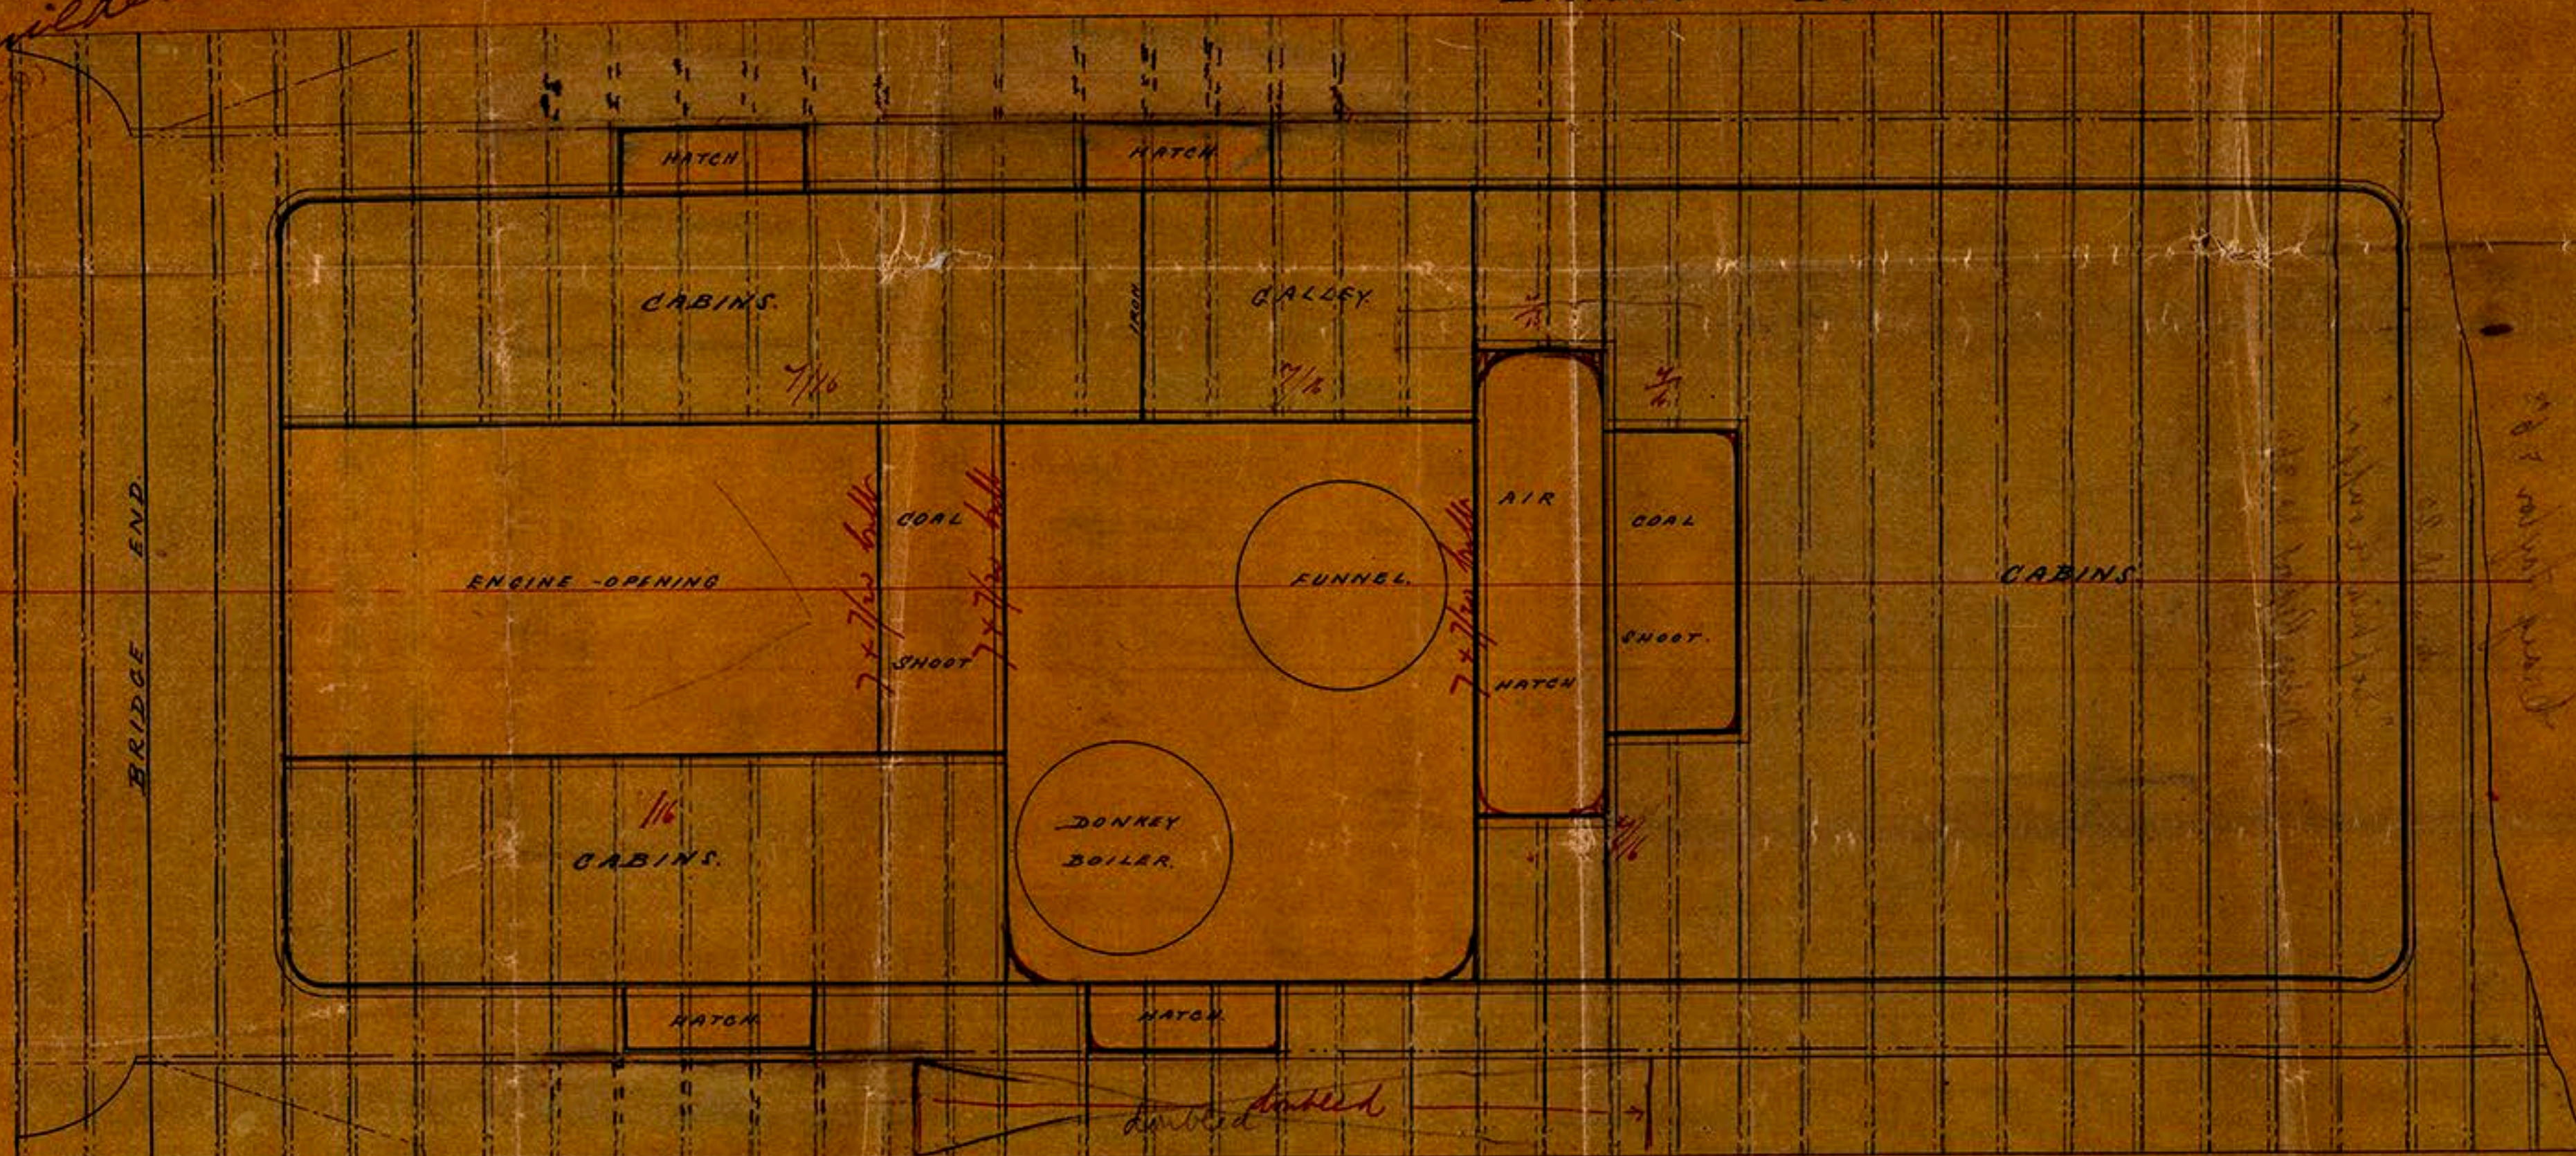


S.S. No 25-  
Scale  $\frac{1}{4}$  in = 1 ft.



STRONG BEAMS

MAIN DECK.

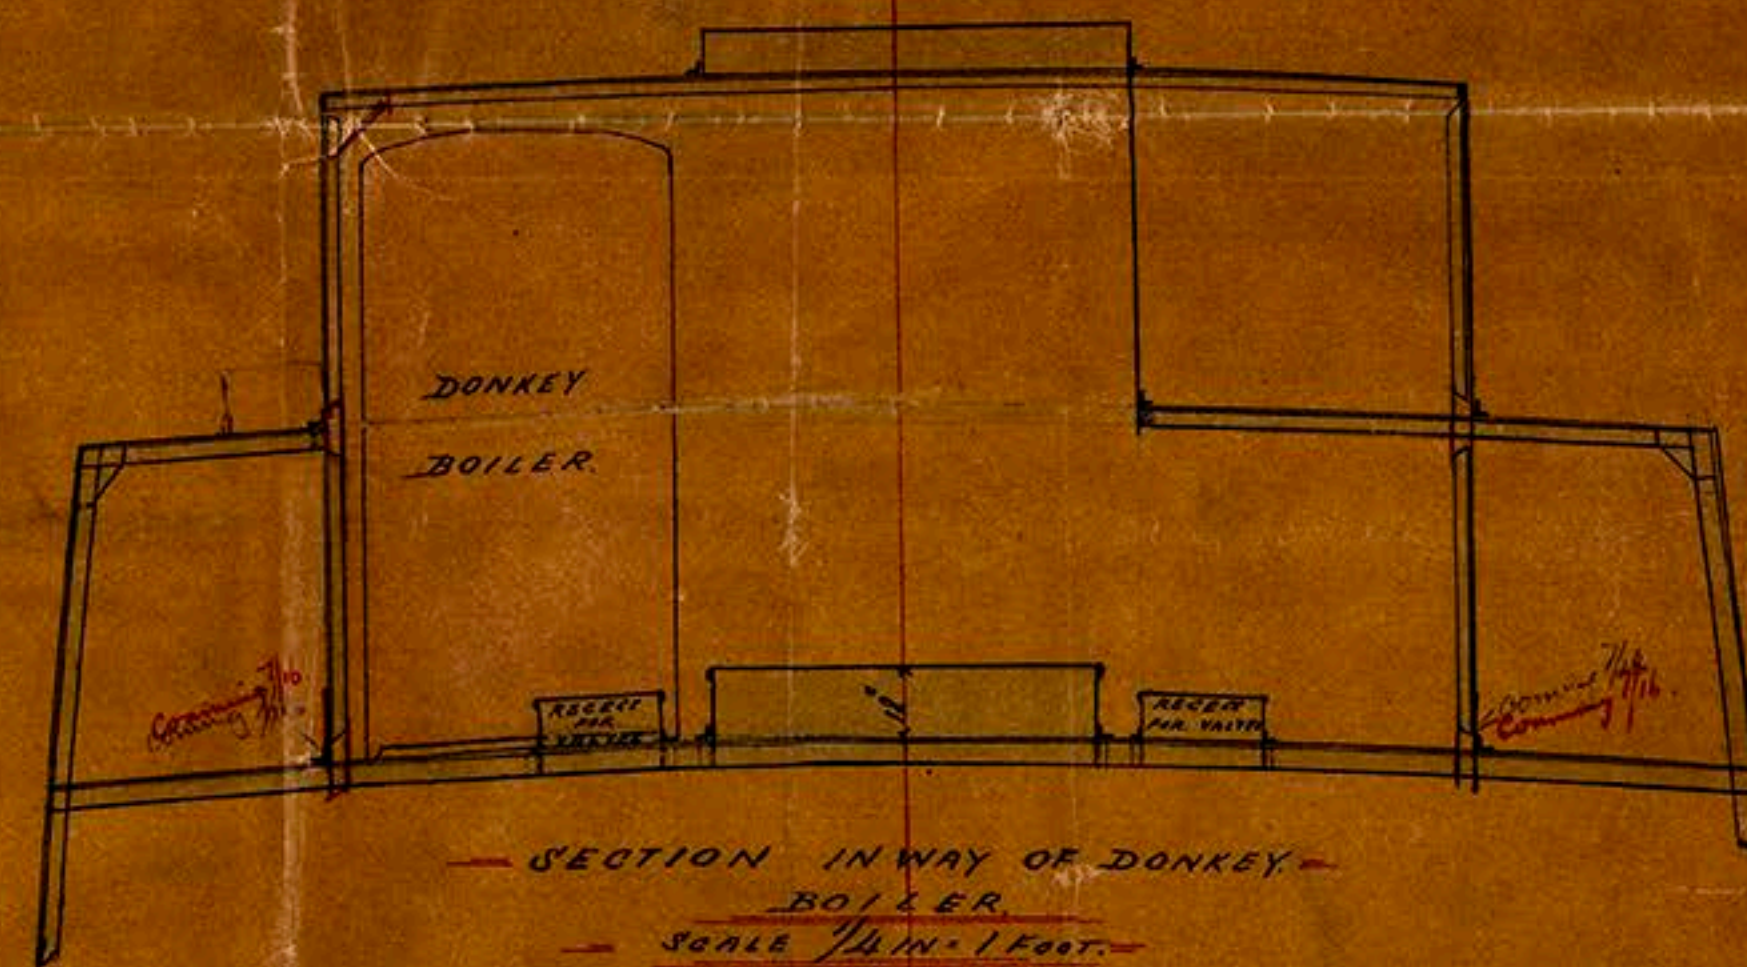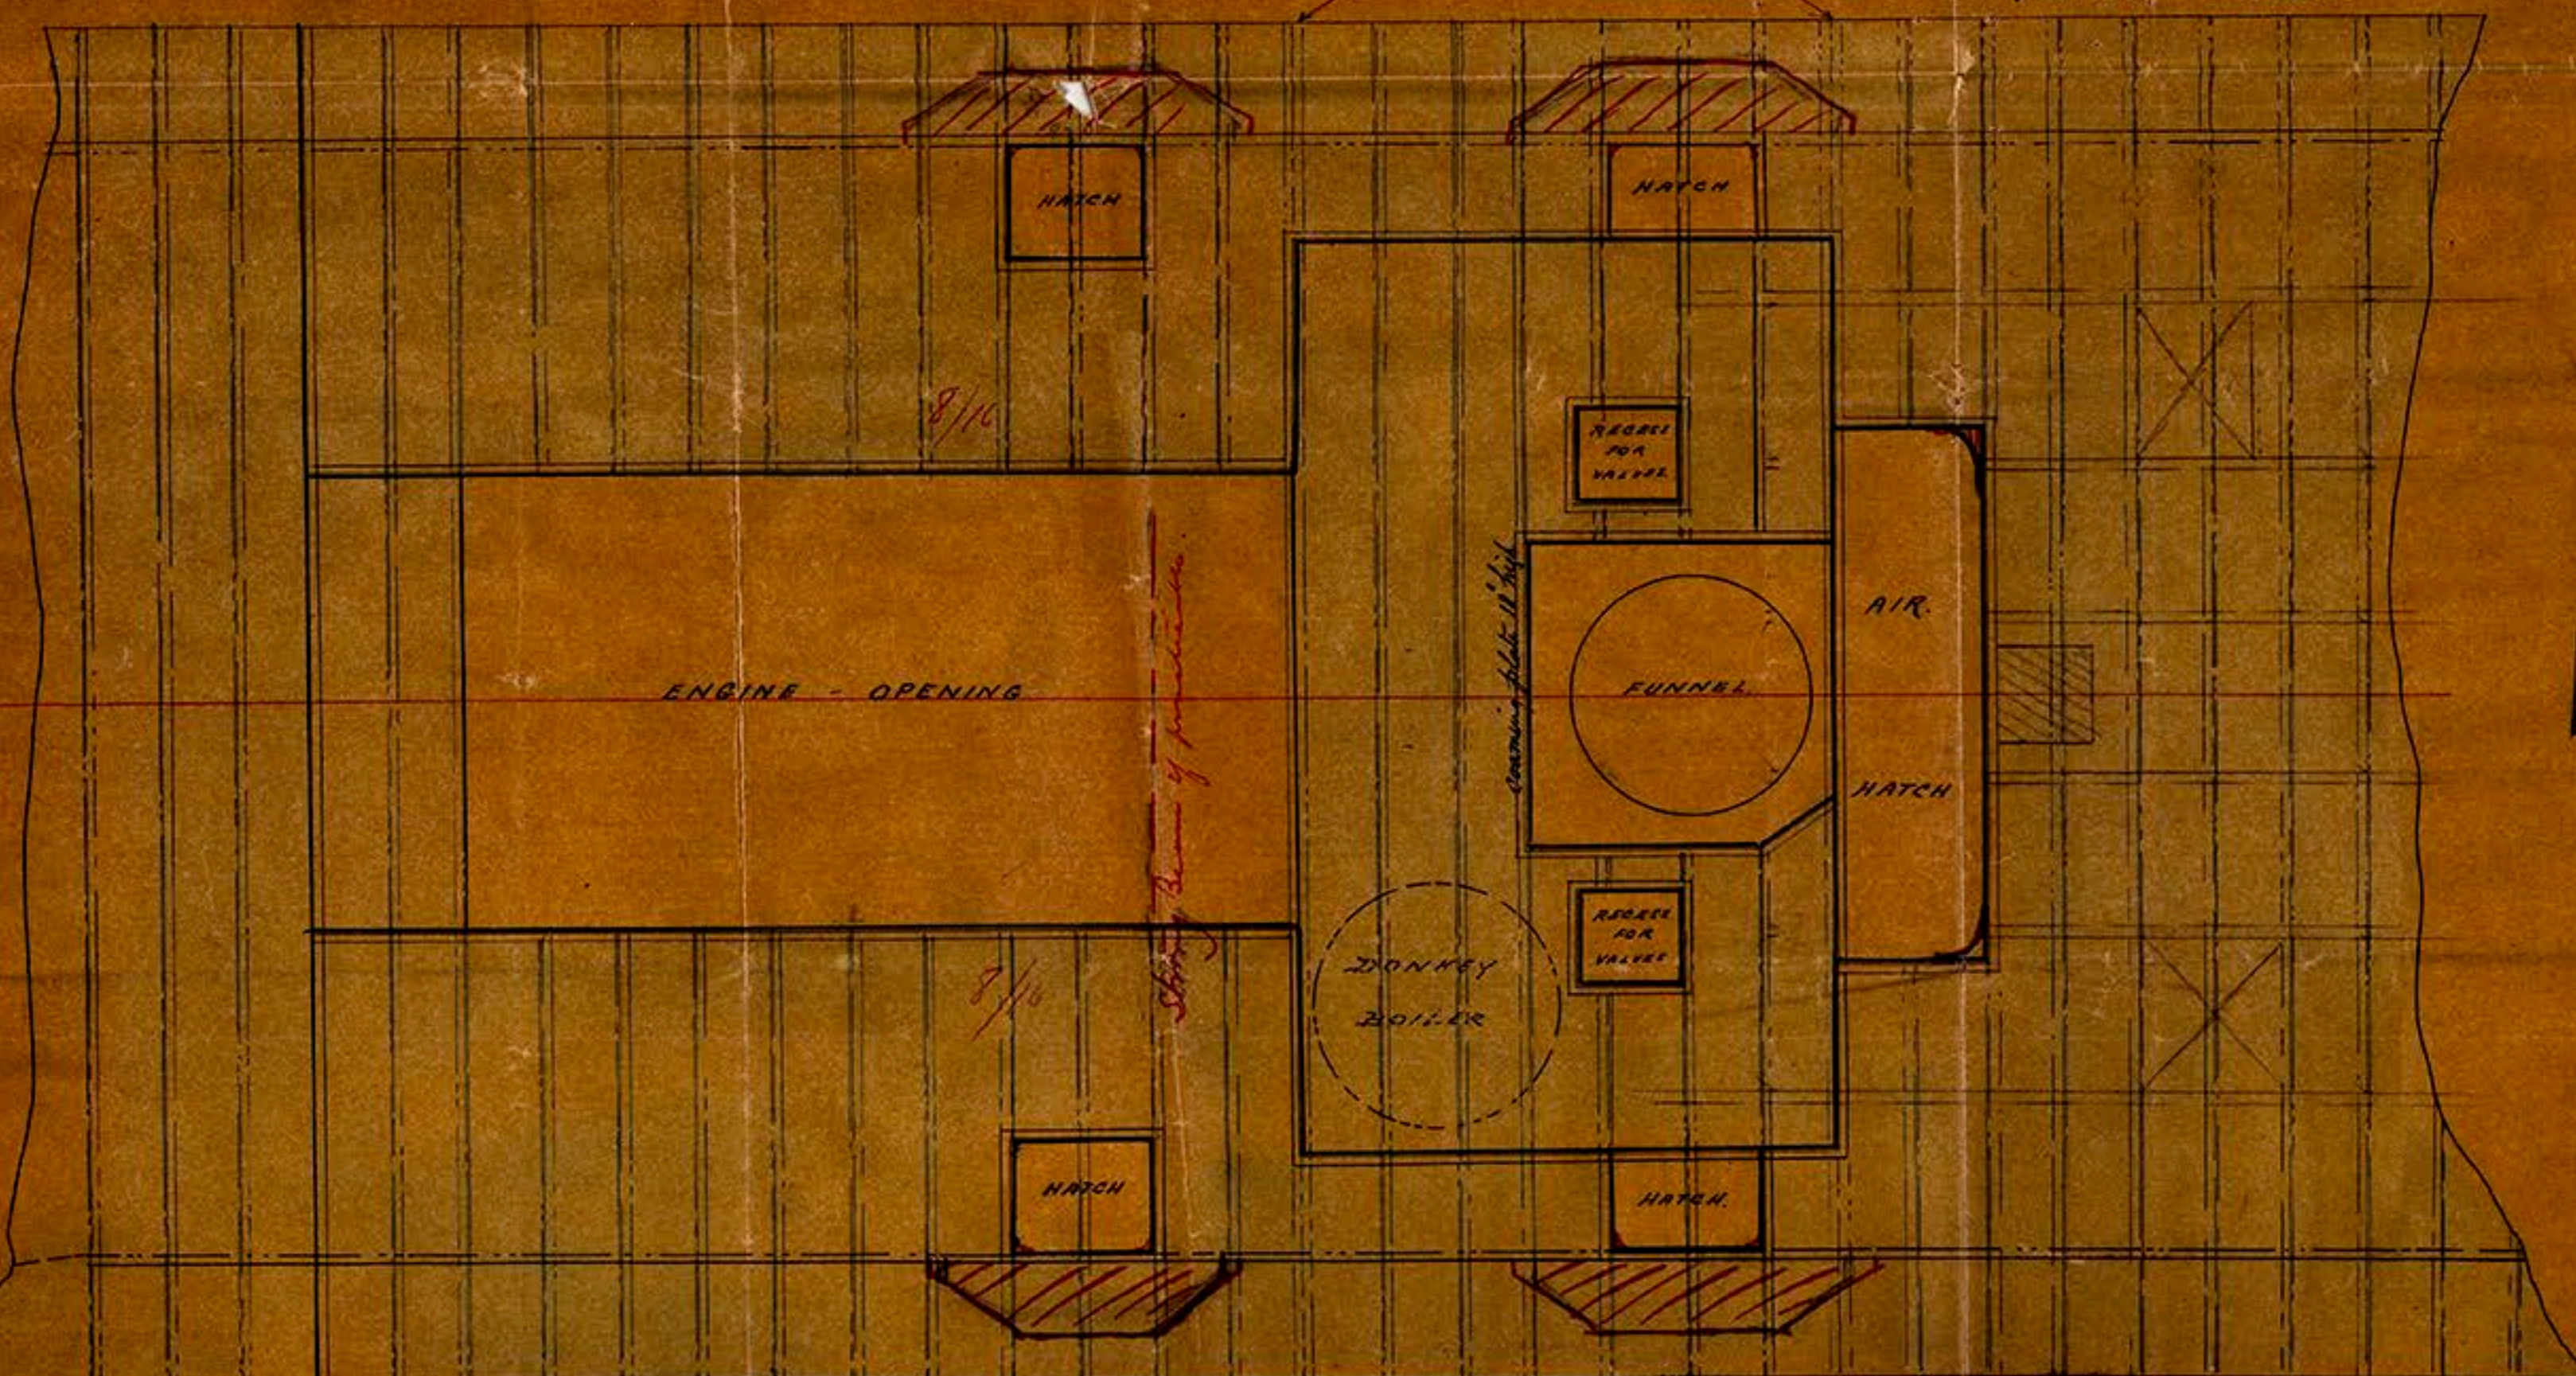

No of Drawing 1517.

*Geo. B. Builders*  
1/12/90

