

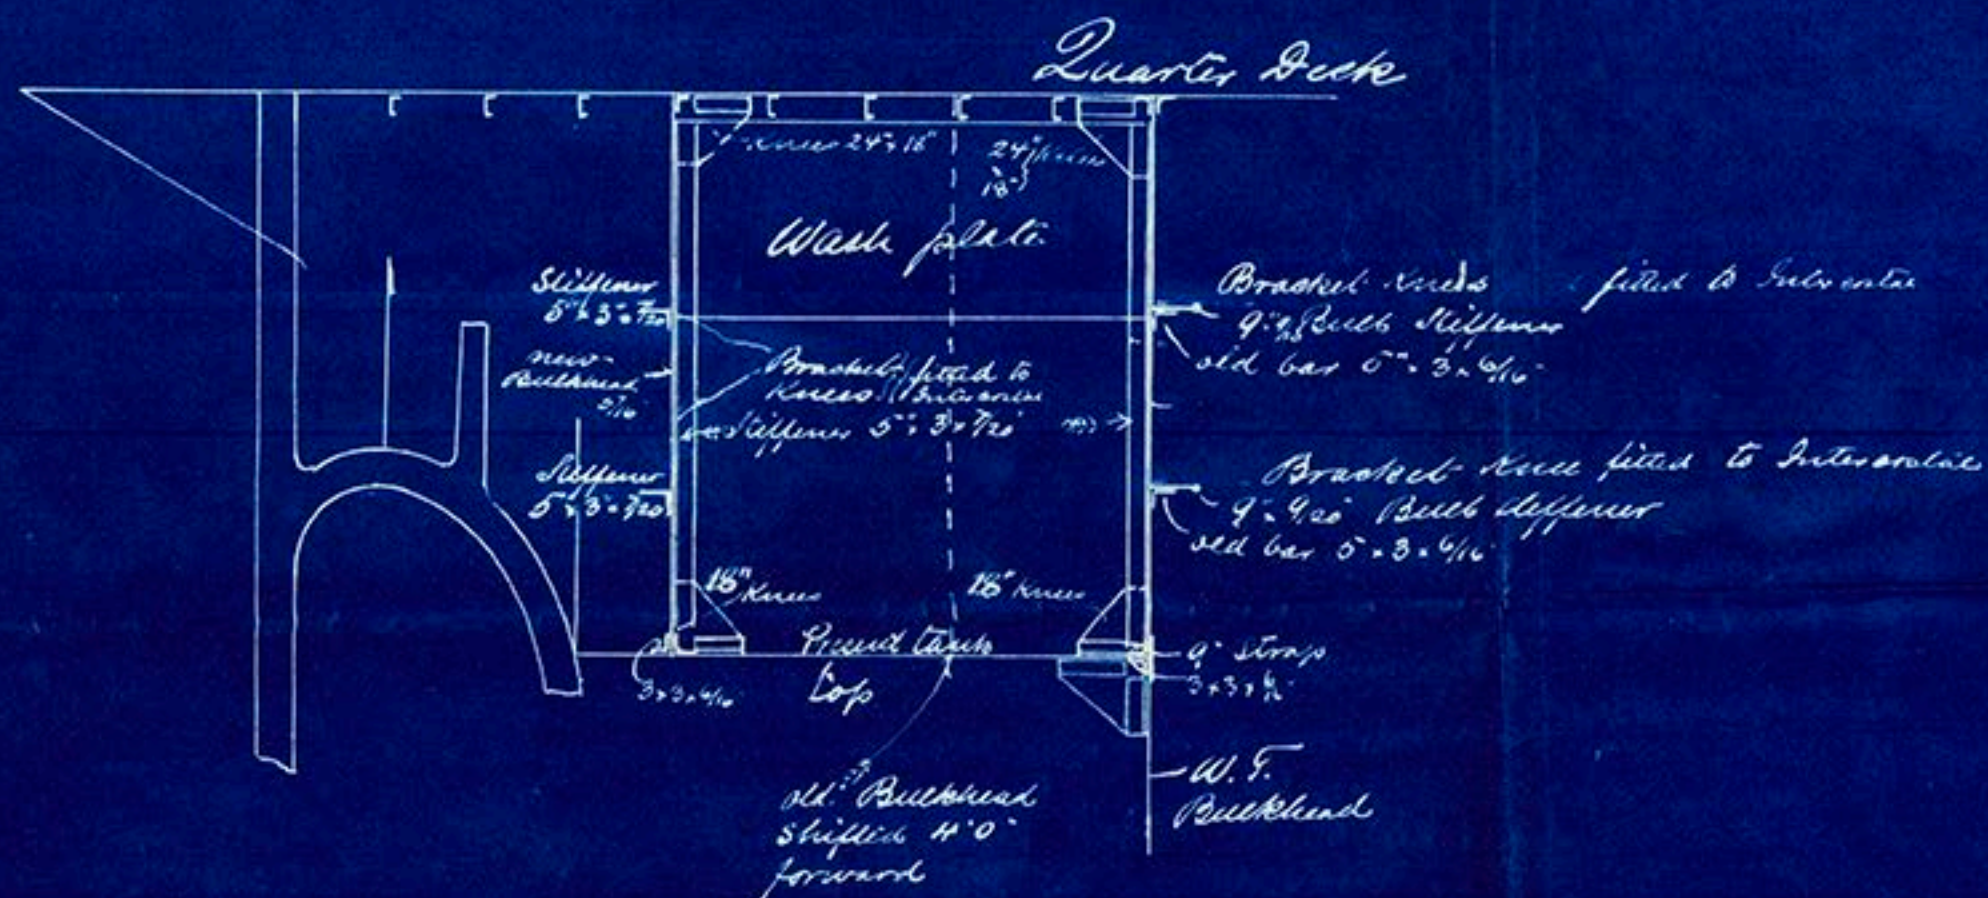


*S.S. Sophia Coussa*  
 plan showing arrangement  
 of new after tank  
 Seal 14 in on foot

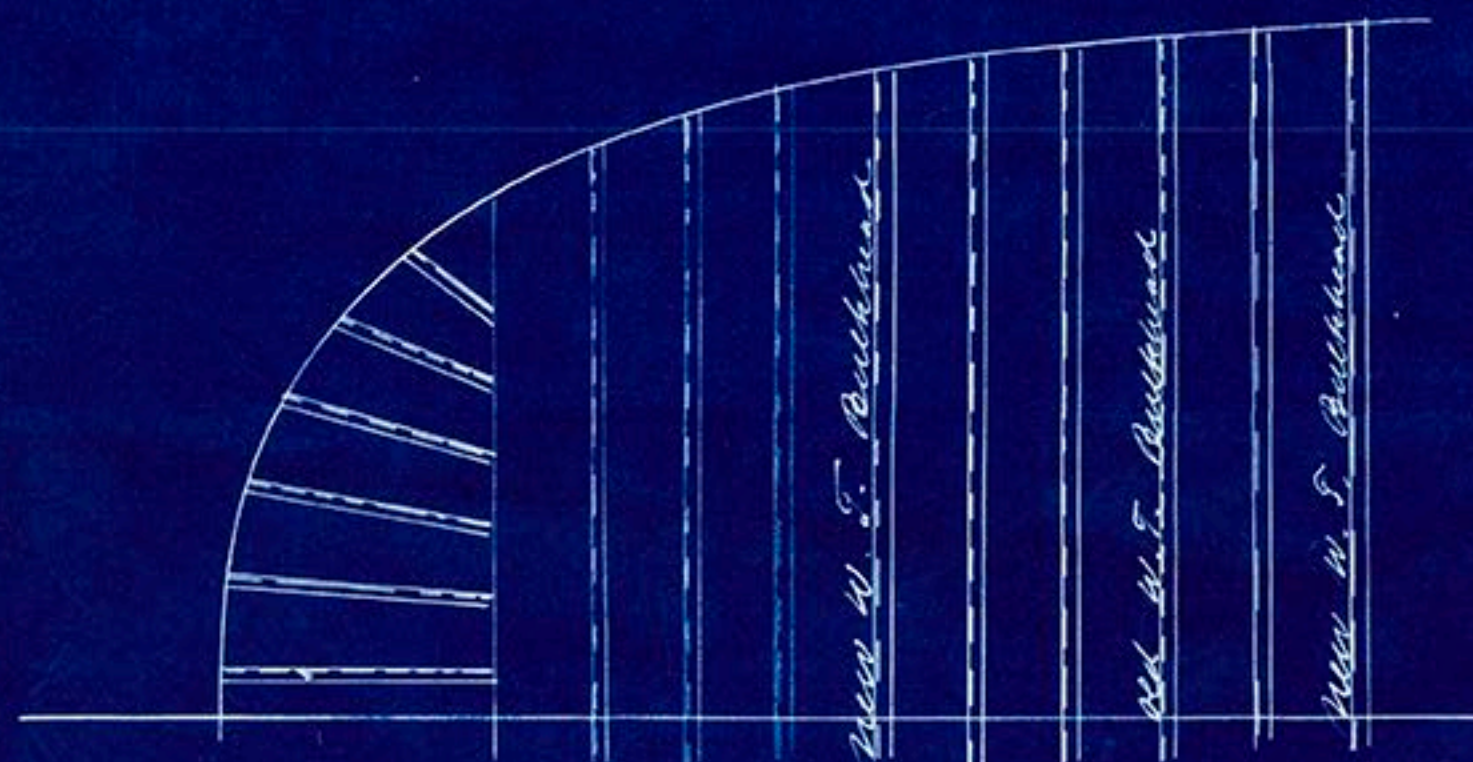


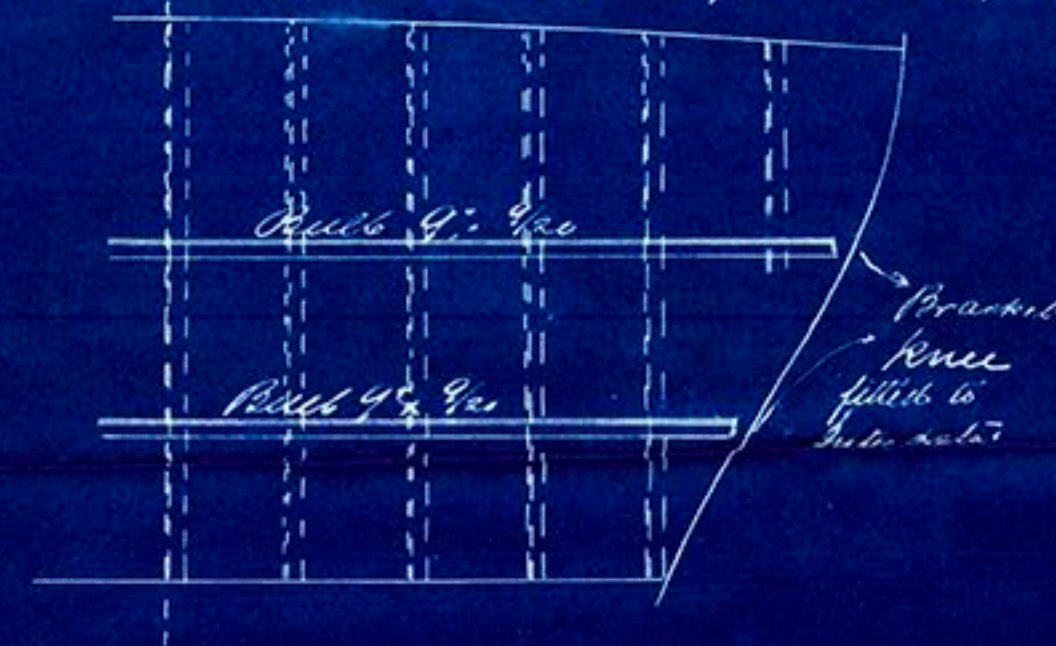

© 2018  
 Lloyd's Register  
 Foundation



MD0741A/71

S.S. Sophia Couppa

Sketch showing arrangement  
of new after Peak Tank.



© 2018

Lloyd's Register  
Foundation