


26/7/90
 23

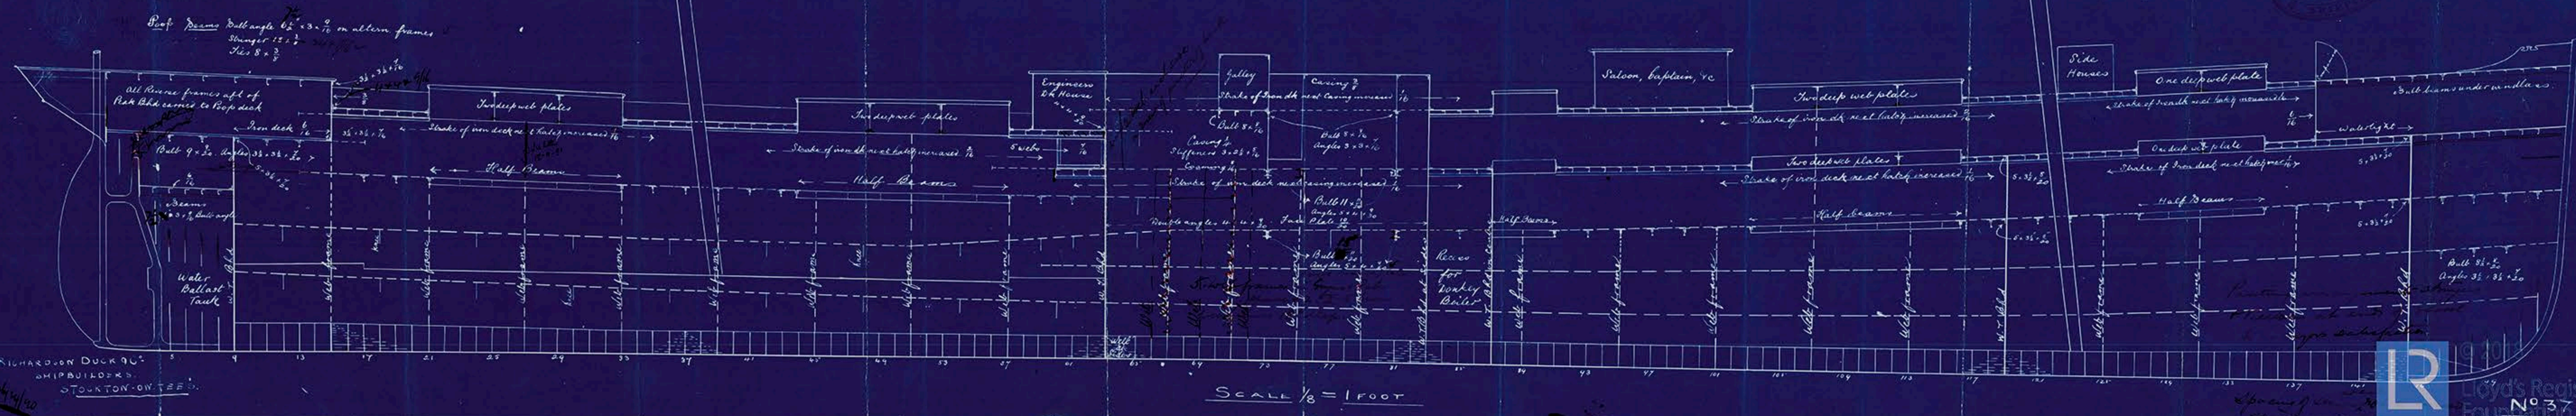

RICHARDSON DUCK 90°
 SHIPBUILDERS
 STOKTON-ON-TEES

Profile
of
Mess^r. Richardson Duck & Co
No. 37 & S.S.
S.S. "Avon"
Intro Report No. 367



© 2018

Lloyd's Register
Foundation

MD8741A/95